

# Mec E 468 Numerical Simulation in Mechanical Engineering Design

## AUTOMARK REPORT

Semester: Win 2022

Instructor: Prof. David S. Nobes

Student Name:

Assignment: Assignment No 1

PROCESSING DATE: July 5, 2022

*AUTOMark Assessment Grade: 727 out of 727*

*AUTOMark Recommended Grade: 100 out of 100*

**NOTE:** This grade is preliminary only and needs to be confirmed.

The following pages include each of the drawings in the following order:

- Your submission
- Your submission marked by AutoMARK
- The solution

**Other important points:**

- Examples are given on eClass of how to interpret the mark-up symbols used by AUTOMark.
- If you have any questions, discuss with your TA in the next lab time.

DRAWING CREATION DATE: 28-Sep-2010 08:59:34

DRAWING LAST SAVE DATE: 30-Jun-2022 10:37:20

MODEL CREATION DATE: 23-Sep-2010 11:25:48

MODEL LAST SAVE DATE: 30-Jun-2022 10:37:20

AutoMARK details:

- Sheetnames should contain only alphabetical characters
- Weights of feature properties are set by the marker
- AutoMARK v 4.0 software written and designed by Owen Stadlwieser


AutoMARK Criterion (The weights of these criterion are decided by the marker):

- DRAWING: SheetOrder, ExtraSheets
- SHEET: SheetPaperSize, SheetScale, SheetTemplate, SheetExtraBOMS, SheetExtraViews, SheetViewTypes, SheetIntersectingBalloons
- BILLOFMATERIALS: BOMTableType, BOMNumberColumns, BOMNumberRows, BOMPosition, BOMTableHeight, BOMTableWidth, BOMFontType, BOMFontSize
- VIEW: ViewScale, ViewDisplayStyle, ViewExtraDimension, ViewPosition, ViewExtraCenterMarks, ViewMass, ViewMaterial, ViewExtraDatums, ViewWrongProjection, ViewExtraCenterlines
- DIMENSION: DimensionDangling, DimensionWrongView, DimensionPosition, DimensionArrowSide, DimensionValue, DimensionBadText
- CENTERLINE: CenterlineDangling, CenterlinePosition
- CENTERMARK: CentermarkDangling, CentermarkPosition, CentermarkShowlines, CentermarkAngle, CentermarkConnectionLines, CentermarkExtensions, CentermarkGap, CentermarkSize, CentermarkGroupedCorrectly
- DATUM: DatumDangling, DatumWrongView, DatumPosition, DatumLabel, DatumDisplayStyle, DatumFilledTriangle
- Balloon: BalloonDangling, BalloonPosition

<i>Symbol/Colour</i>	<i>Meaning</i>
✓	No deductions on feature
Colour	Incorrect value
Colour	Miscellaneous error
Colour	Incorrect Position
Colour	Unrecognized feature
Colour	Missing feature
?	Feature not found on key

8 7 6 5 4 3 2 1

ITEM NO.	SW-File Name(File Name)	SW-Title(Title)	Material	SW-Author(Author)	QTY.
1	MecE265_Car_Hub	Hub, Disk and Calaper Assembly	Various	D.S. Nobes	1
2	dsn_Rim	Custom Low Speed Snow Rim	Pure Gold	D.S.Nobes	1
3	MecE_265_Nut	ACME HTNUT 0.500-20-D-N	Brass	Wyle E. Coyote	5
4	MecE_265_Tire	Snow Plow Car Tire	Rubber	D.S. Nobes	1

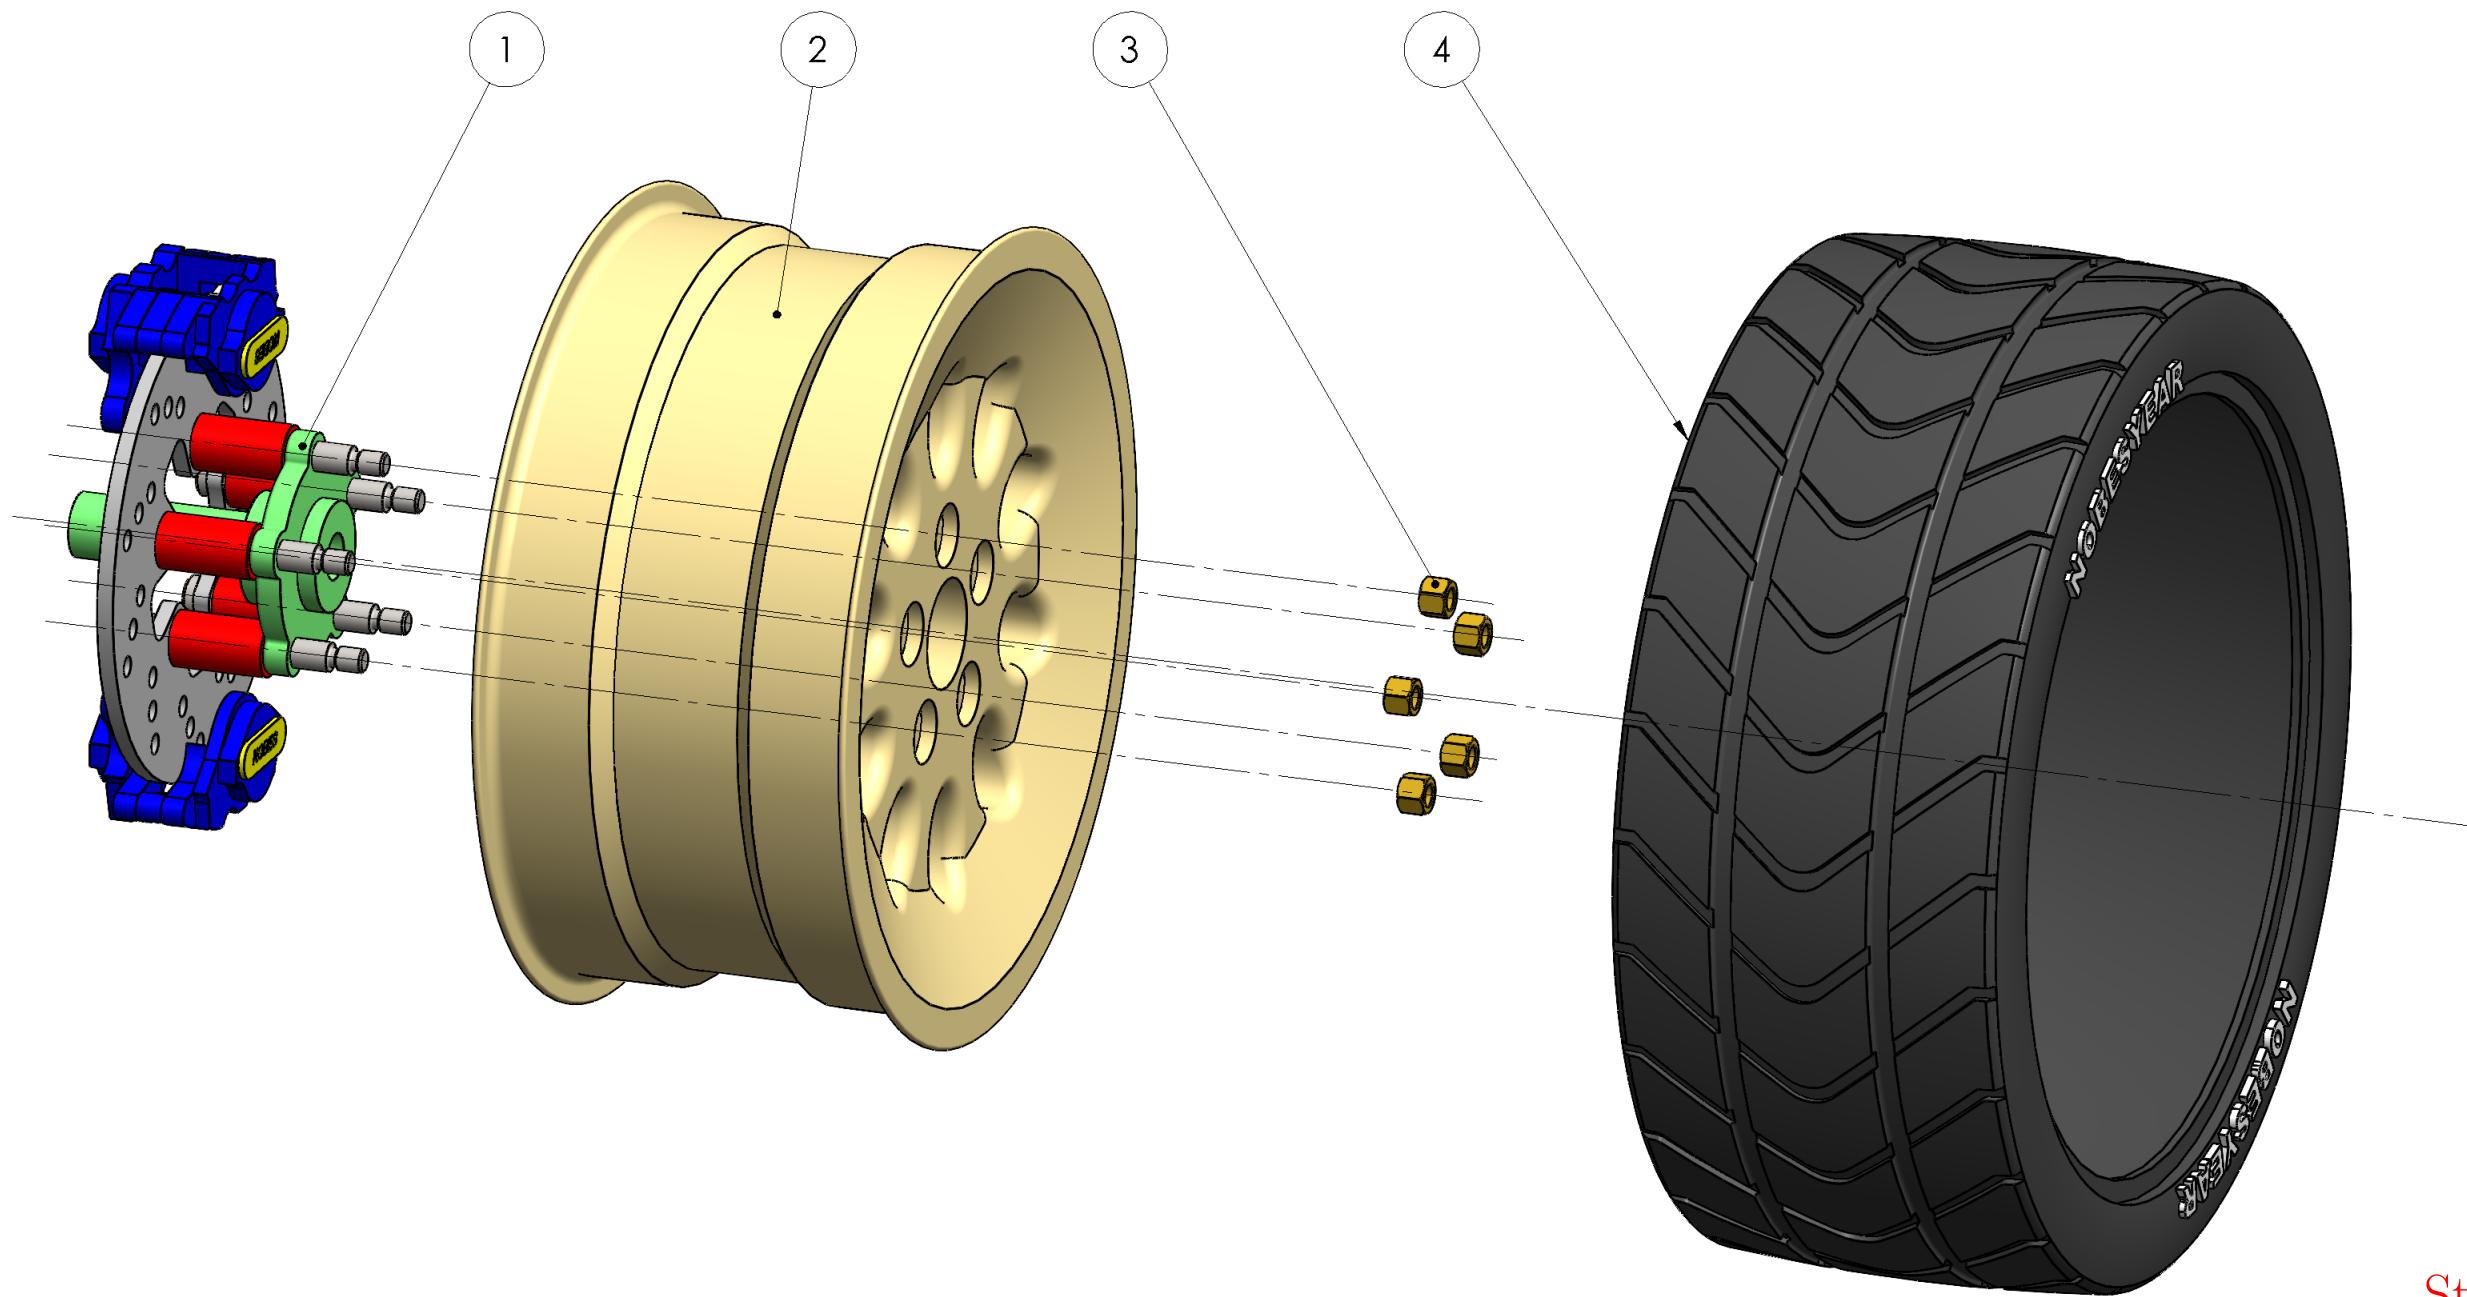

### Student Submission

<b>MecE 265</b>	UNLESS OTHERWISE SPECIFIED: DIMENSIONS ARE IN MM TOLERANCES: ANGULAR: $\pm 0.5^\circ$ LINEAR $X = \pm 0.5$ $X.X = \pm 0.1$ $XXX = \pm 0.025$	DRAWN BY: <b>David S. Nobes</b>
Instructor: <b>Dr DS Nobes</b> Fall 2021	Comments:	Lab Day ALL
		SM By <b>D.S.Nobes</b>
	SURFACE FINISH $0.6 \mu\text{m}$	TA Initials DSN
	DO NOT SCALE DRAWING	zacha June 30, 2022 10:37:20 AM September 23, 2010 11:25:48 AM
MATERIAL: Various	FILE NAME: MecE265_Car_Hub_Rim_Tire	SIZE <b>B</b> Assignment Number <b>Assignment 03</b> REV <b>2</b>
SCALE: 1:4 Mass: 175308.62 SHEET 1 OF 3		

The Department of Mechanical Engineering  
UNIVERSITY OF ALBERTA

TITLE:

**Hub, Rim, Tire  
Assembly**

8

7

6

5

4

3


2

Snapped to Corner

Drawing View15: 48/48  
DetailItem439: 40/40  
SHEET TOTAL: 137/137

Correct Height  
Correct Font  
Correct Font Size  
Correct Column Order  
Correct Content

ITEM NO.	SW-File Name(File Name)	SW-Title(Title)	Material	SW-Author(Author)	QTY.
1	MecE265_Car_Hub	Hub, Disk and Calaper Assembly	Various	D.S. Nobes	1
2	dsn_Rim	Custom Low Profile Snow Rim	Pure Gold	D.S.Nobes	1
3	MecE_265_Nut	ACME HTNUT 0.500-20-D-N	Brass	Wyle E. Coyote	5
4	MecE_265_Tire	Snow Plow Car Tire	Rubber	D.S. Nobes	1

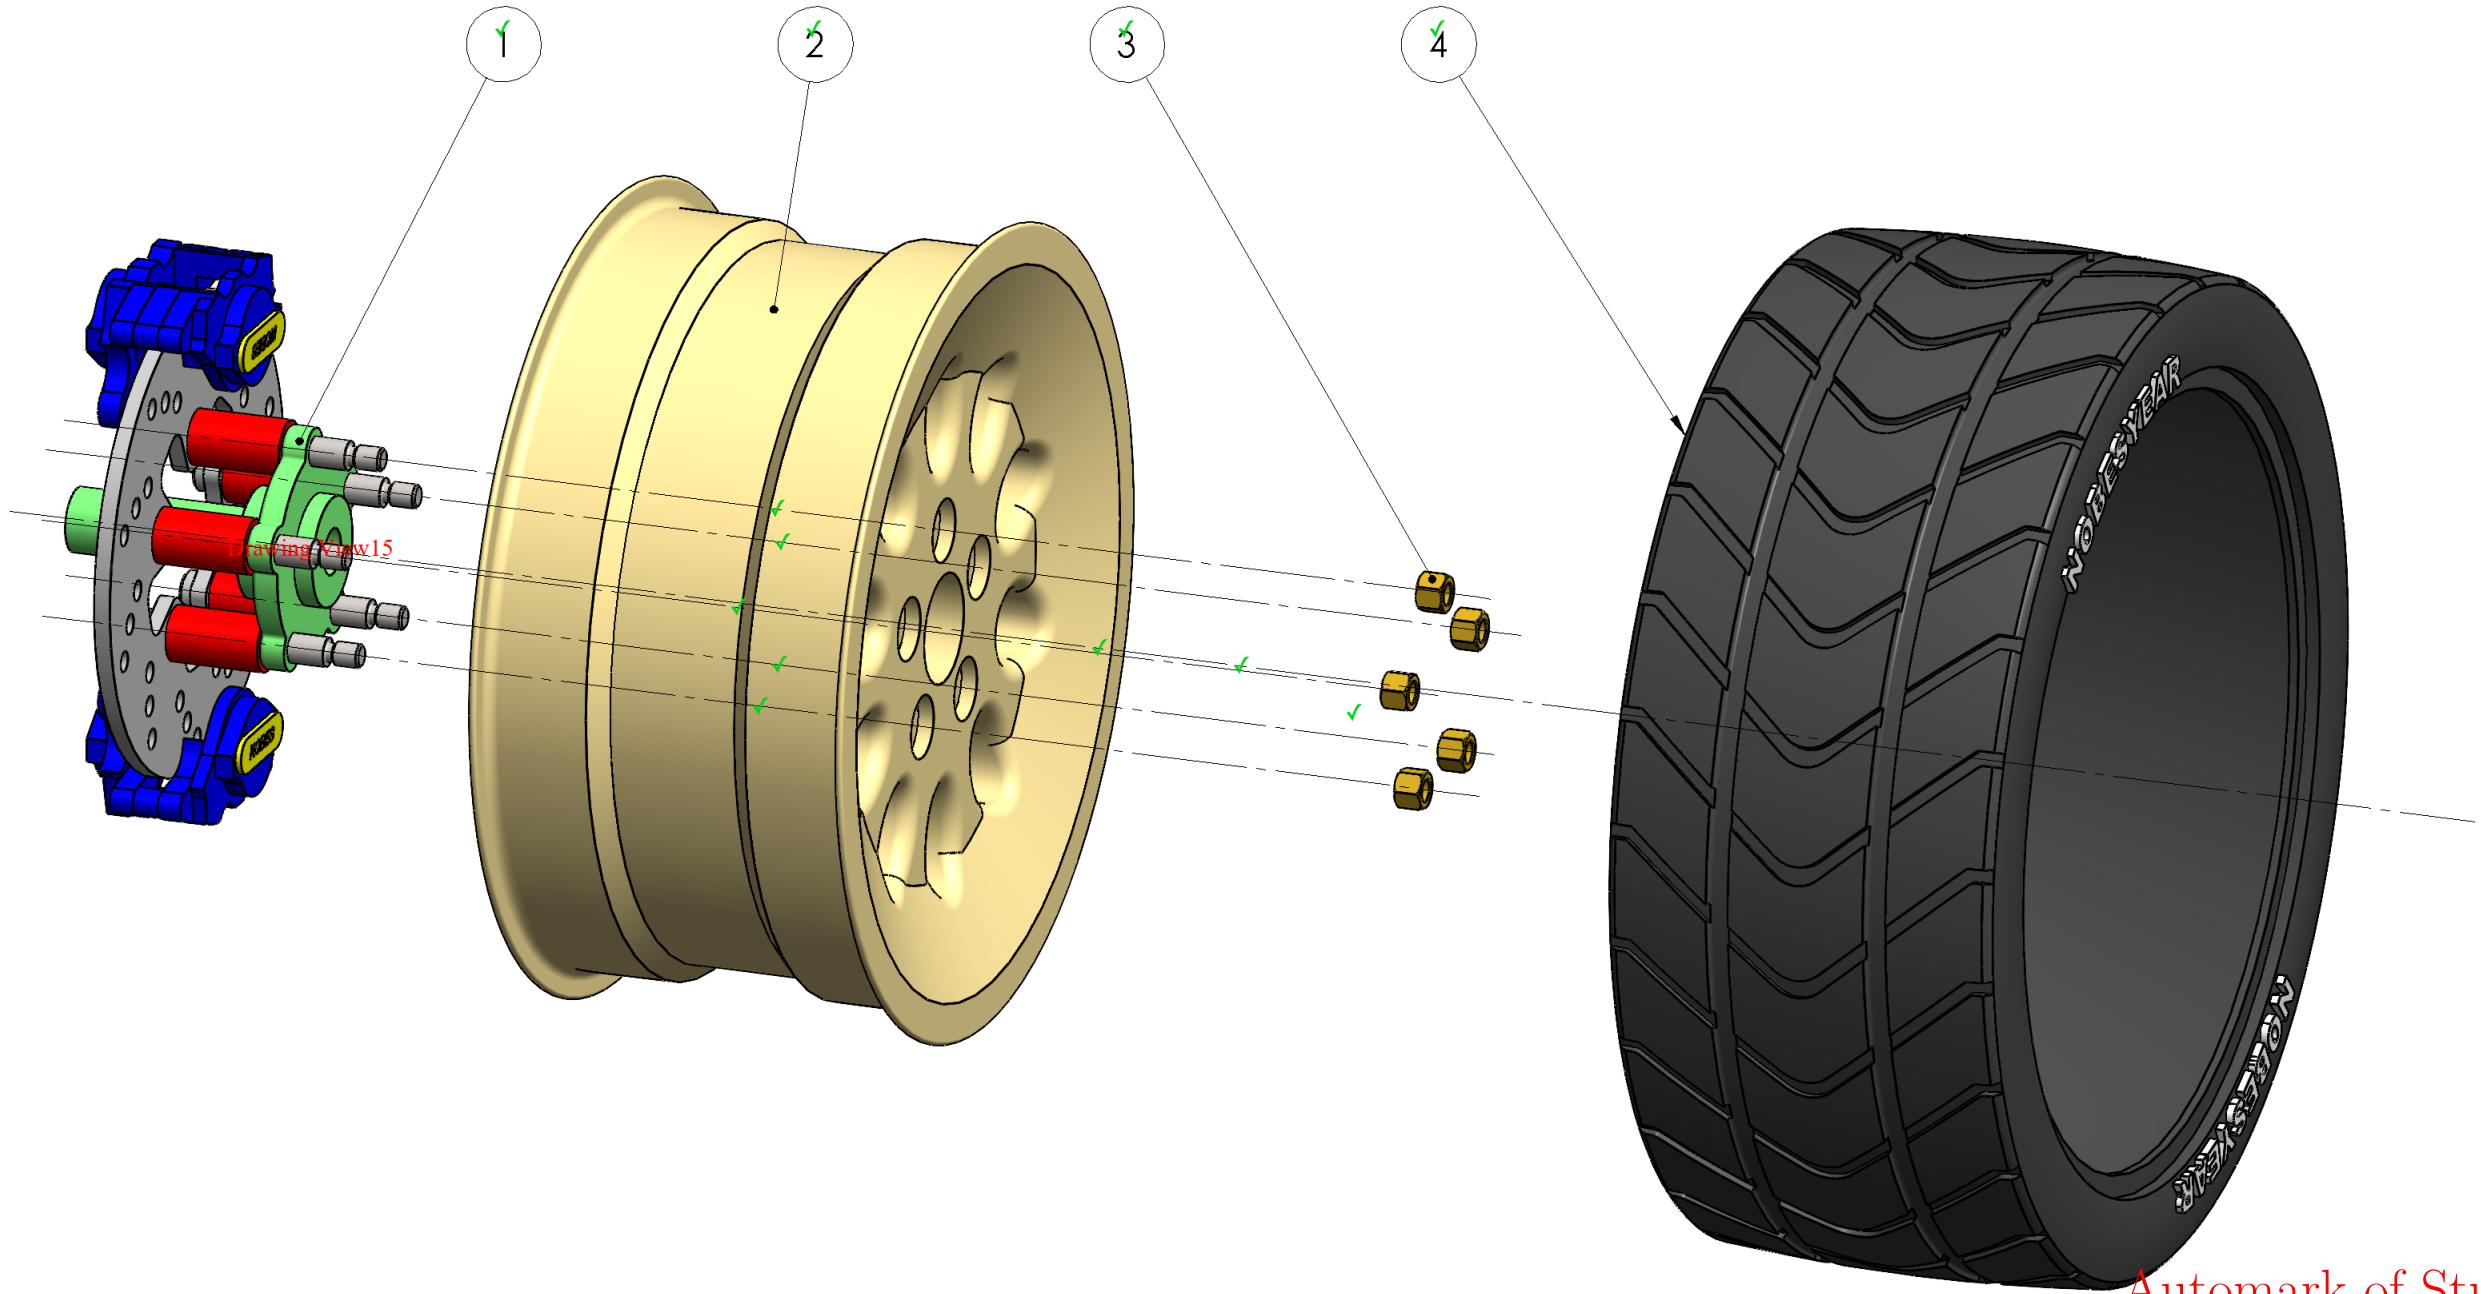

Automark of Student Submission

Correct Tangent Line style  
Correct Scale  
Correct Display style

<b>MecE 265</b>	UNLESS OTHERWISE SPECIFIED:	DRAWN BY:
Instructor: <b>Dr DS Nobes</b> Fall 2021	DIMENSIONS ARE IN MM	<b>David S. Nobes</b>
Comments:	TOLERANCES: ANGULAR: $\pm 0.5^\circ$ LINEAR X = $\pm 0.5$ X.X = $\pm 0.1$ XXX = $\pm 0.025$	Lab Day ALL
	SURFACE FINISH 0.6 $\mu\text{m}$	SM By <b>D.S.Nobes</b>
	DO NOT SCALE DRAWING	TA Initials DSN
MATERIAL: Various	zacha	
FILE NAME: MecE265_Car_Hub_Rim_Tire	June 30, 2022 10:37:20 AM September 23, 2010 11:25:48 AM	

The Department of Mechanical Engineering  
UNIVERSITY OF ALBERTA


TITLE:

**Hub, Rim, Tire  
Assembly**

SIZE	Assignment Number	REV
<b>B</b>	<b>Assignment 03</b>	2
SCALE: 1:4	Mass: 175308.62	SHEET 1 OF 3

8 7 6 5 4 3 2 1

ITEM NO.	SW-File Name(File Name)	SW-Title(Title)	Material	SW-Author(Author)	QTY.
1	MecE265_Car_Hub	Hub, Disk and Calaper Assembly	Various	D.S. Nobes	1
2	dsn_Rim	Custom Low Speed Snow Rim	Pure Gold	D.S.Nobes	1
3	MecE_265_Nut	ACME HTNUT 0.500-20-D-N	Brass	Wyle E. Coyote	5
4	MecE_265_Tire	Snow Plow Car Tire	Rubber	D.S. Nobes	1

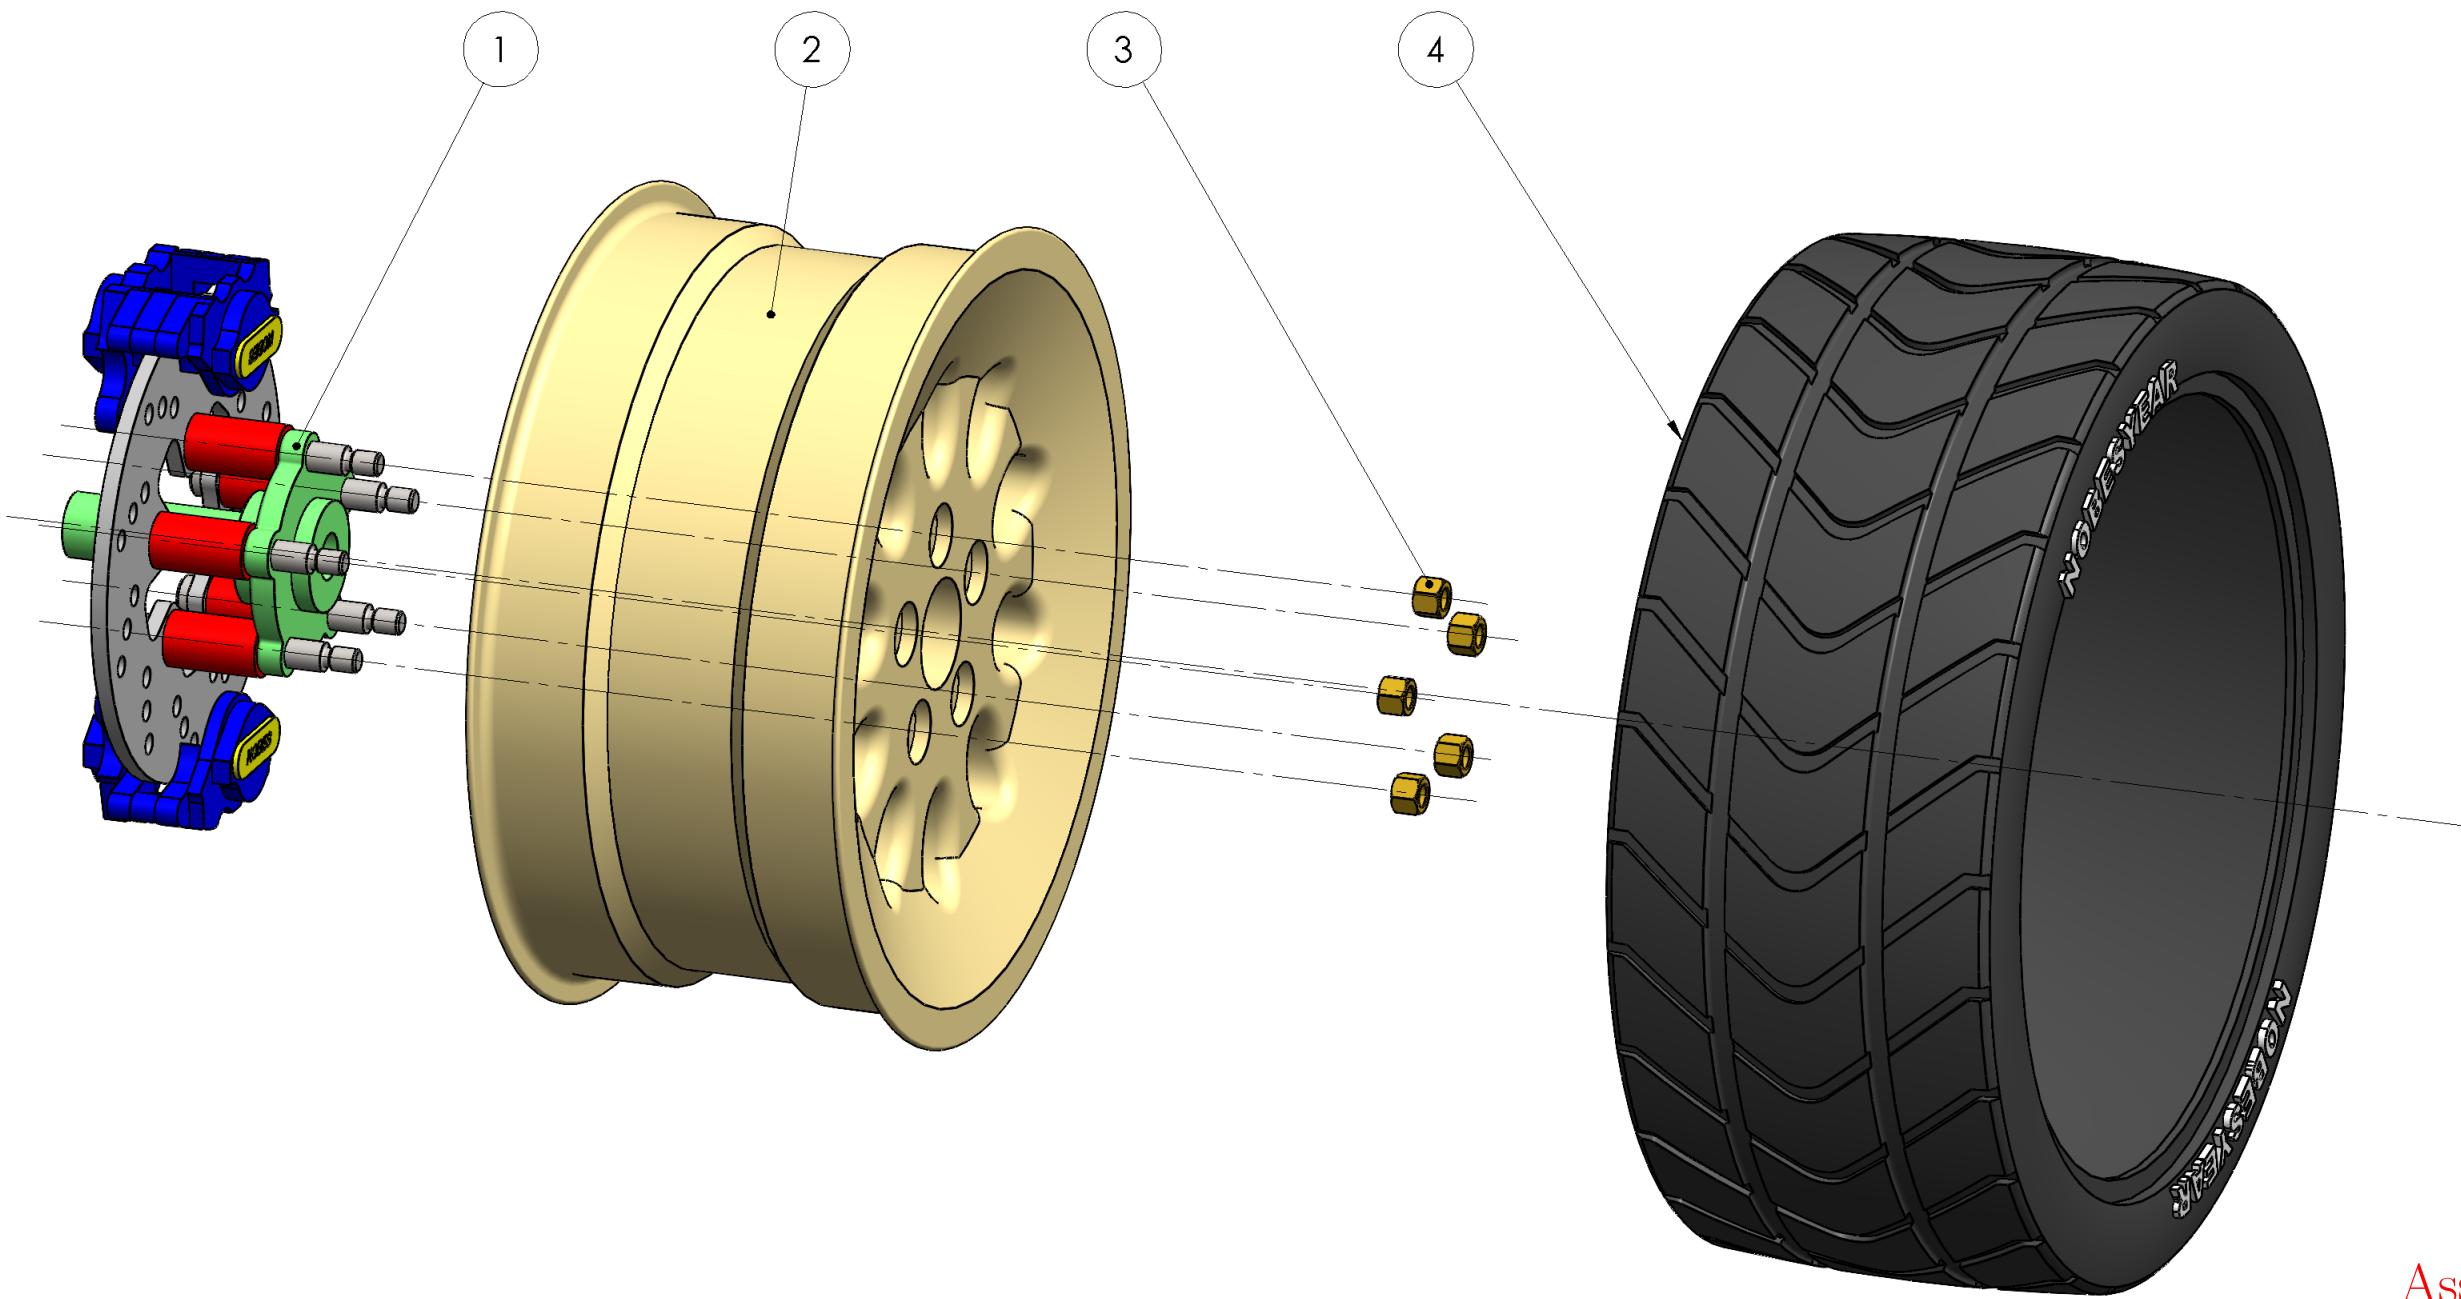

## Assignment Solution

<b>MecE 265</b>	UNLESS OTHERWISE SPECIFIED: DIMENSIONS ARE IN MM TOLERANCES: ANGULAR: $\pm 0.5^\circ$ LINEAR $X = \pm 0.5$ $X.X = \pm 0.1$ $XXX = \pm 0.025$	DRAWN BY: <b>David S. Nobes</b>
Instructor: <b>Dr DS Nobes</b> Fall 2021	Comments:	Lab Day ALL
		SM By <b>D.S.Nobes</b>
	SURFACE FINISH $0.6 \mu\text{m}$	TA Initials DSN
	DO NOT SCALE DRAWING	zacha September 28, 2021 2:35:53 PM September 23, 2010 11:25:48 AM
MATERIAL: Various	FILE NAME: MecE265_Car_Hub_Rim_Tire	SIZE <b>B</b> Assignment Number <b>Assignment 03</b> REV <b>2</b>
SCALE: 1:4 Mass: 175308.62 SHEET 1 OF 3		

The Department of Mechanical Engineering  
UNIVERSITY OF ALBERTA


TITLE:  
**Hub, Rim, Tire  
Assembly**

8 7 6 5 4 3 2 1


ITEM NO.	SW-File Name(File Name)	SW-Title(Title)	Material	SW-Author(Author)	QTY.
1	MecE265_Car_Hub	Hub, Disk and Calaper Assembly	Various	D.S. Nobes	1
2	dsn_Rim	Custom Low Speed Snow Rim	Pure Gold	D.S.Nobes	1
3	MecE_265_Nut	ACME HTNUT 0.500-20-D-N	Brass	Wyle E. Coyote	5
4	MecE_265_Tire	Snow Plow Car Tire	Rubber	D.S. Nobes	1

D

D

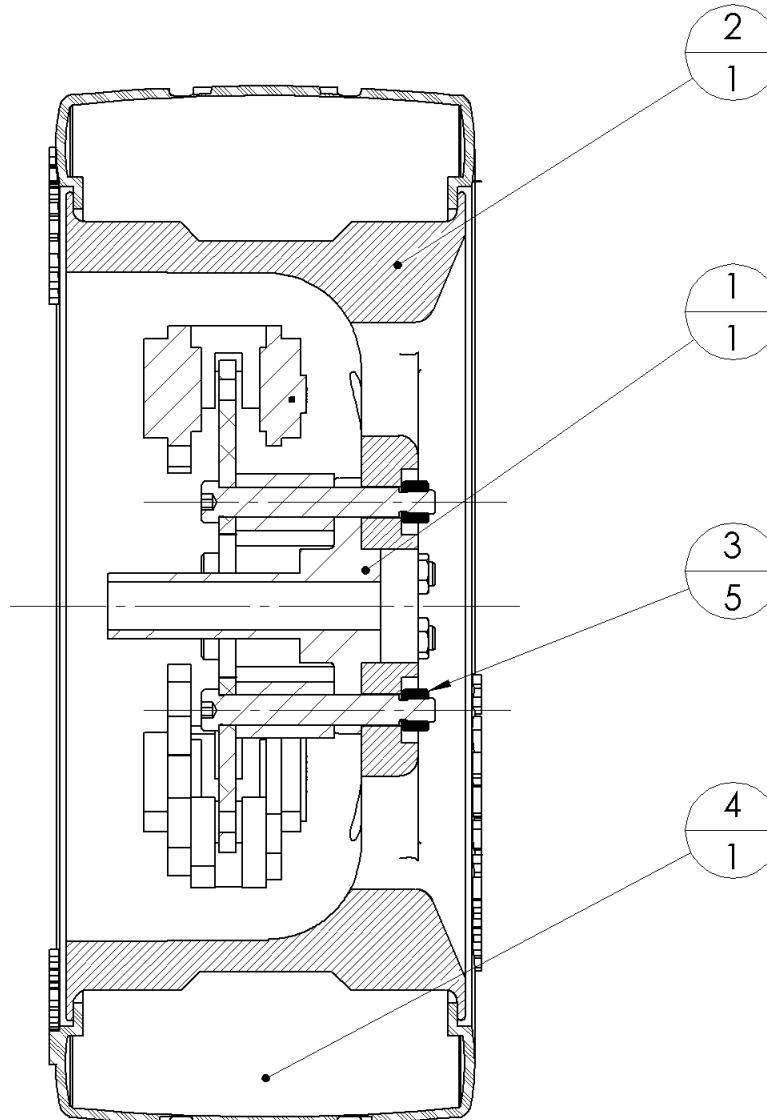

SECTION A-A

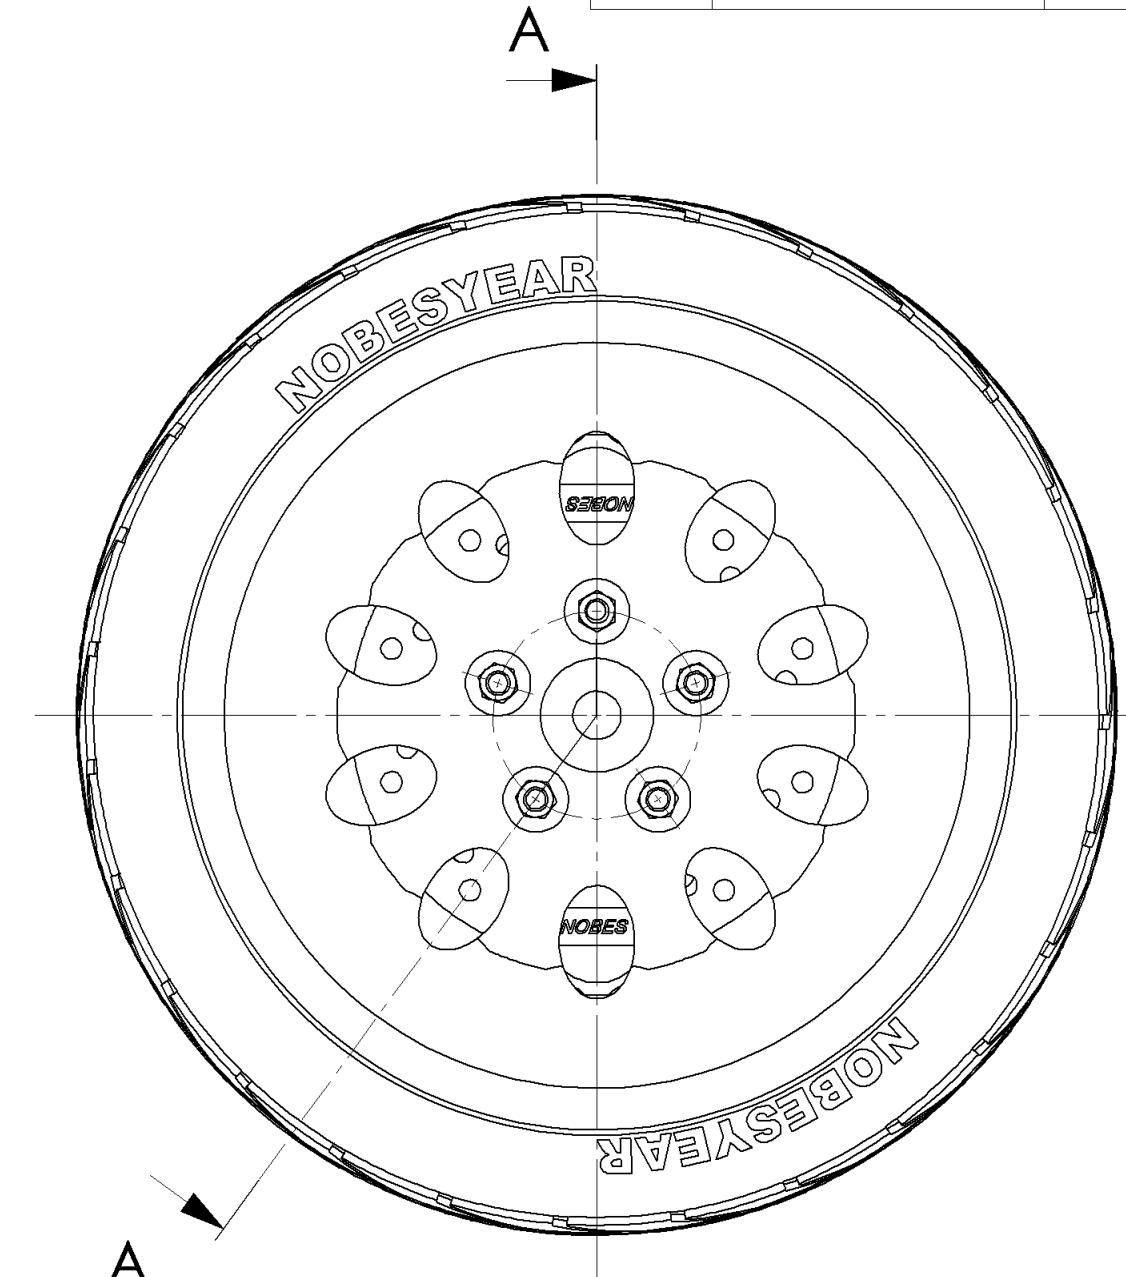

<b>MecE 265</b>		UNLESS OTHERWISE SPECIFIED:	DRAWN BY:
Instructor:	Dr DS Nobes	DIMENSIONS ARE IN MM	David S. Nobes
Comments:	Fall 2021	TOLERANCES:	
		ANGULAR: $\pm 0.5^\circ$	
		LINEAR X = $\pm 0.5$ XX = $\pm 0.1$ XXX = $\pm 0.025$	
		SURFACE FINISH $0.6 \mu\text{m}$	
		DO NOT SCALE DRAWING	
MATERIAL: Various			
FILE NAME: MecE265_Car_Hub_Rim_Tire			
zacha			
June 30, 2022 10:37:20 AM			
September 23, 2010 11:25:48 AM			
SIZE <b>B</b>		Assignment Number	REV
		Assignment 03	2
SCALE: 1:4		Mass: 175308.62	SHEET 2 OF 3

Student Submission  
The Department of Mechanical Engineering  
UNIVERSITY OF ALBERTA

TITLE:

Hub, Rim, Tire  
Assembly

8

7

6

5

4

3



2

Snapped to Corner

Drawing View1: 57/57  
 Section View A-A: 39/39  
 DetailItem493: 40/40  
 SHEET TOTAL: 185/185

Correct Height  
 Correct Font  
 Correct Font Size  
 Correct Column Order  
 Correct Content

ITEM NO.	SW-File Name(File Name)	SW-Title(Title)	Material	SW-Author(Author)	QTY.
1	MecE265_Car_Hub	Hub, Disk and Calaper Assembly	Various	D.S. Nobes	1
2	dsn_Rim	Custom Low Profile Snow Rim	Pure Gold	D.S.Nobes	1
3	MecE_265_Nut	ACME HTNUT 0.500-20-D-N	Brass	Wyle E. Coyote	5
4	MecE_265_Tire	Snow Plow Car Tire	Rubber	D.S. Nobes	1

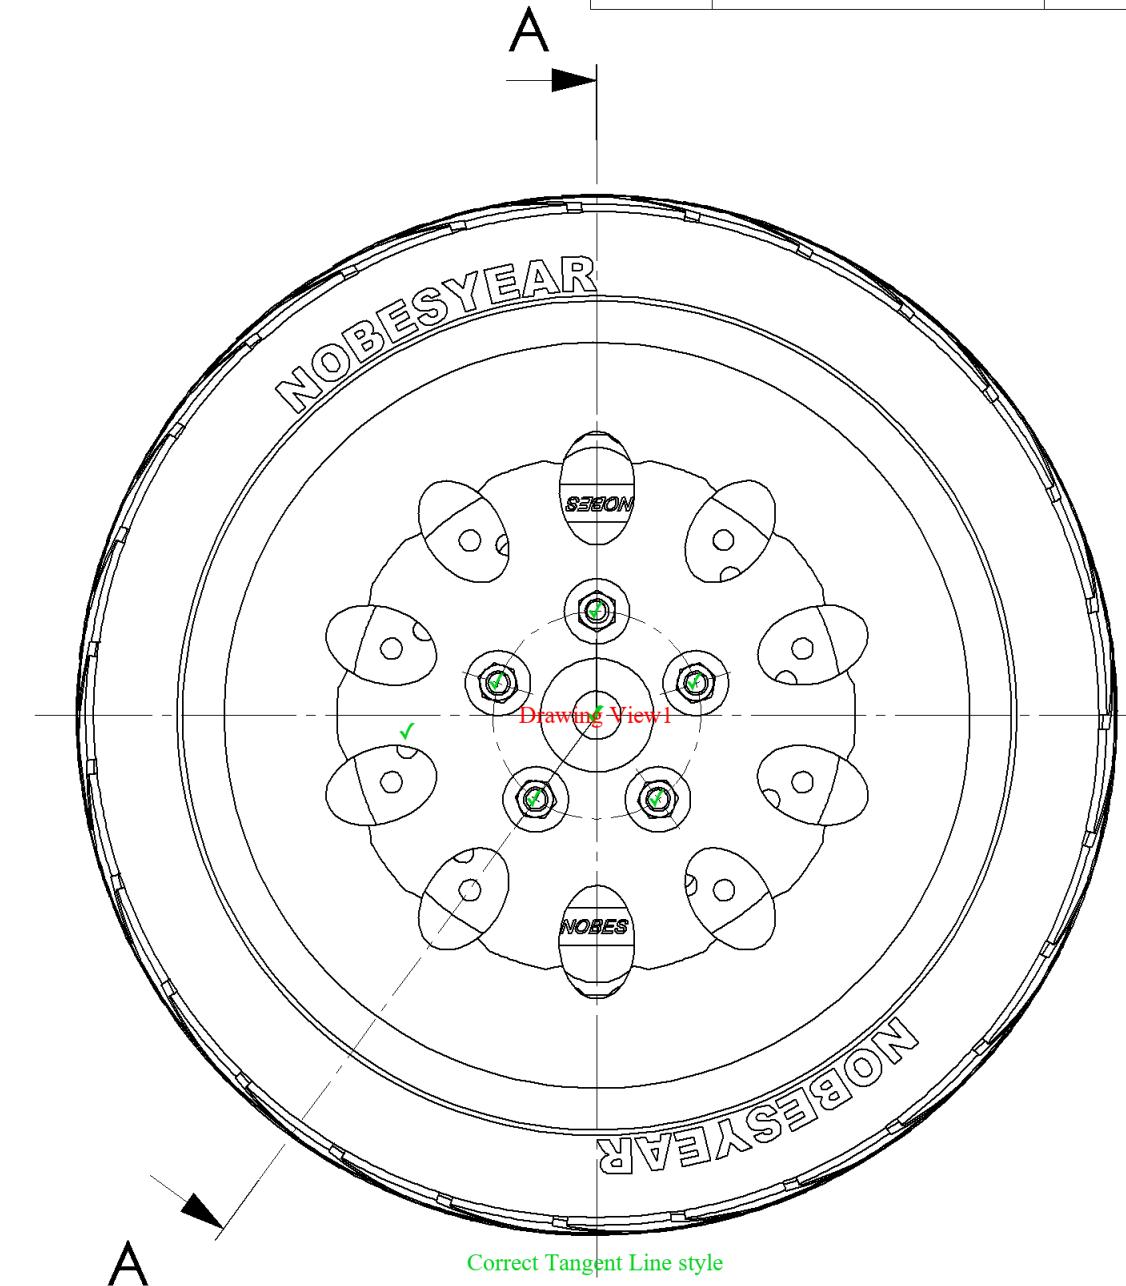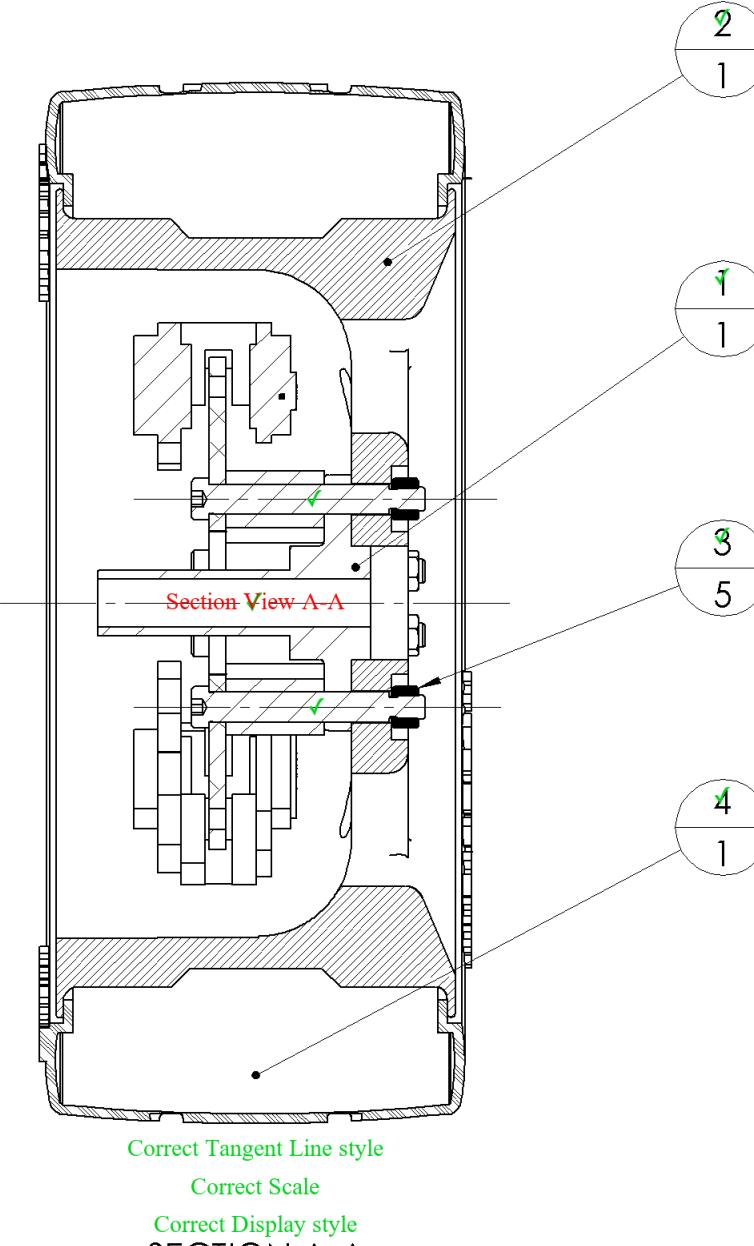


<b>MecE 265</b>		UNLESS OTHERWISE SPECIFIED:
Instructor:	Dr DS Nobes	
Comments:	Fall 2021	
 		DIMENSIONS ARE IN MM TOLERANCES: ANGULAR: $\pm 0.5^\circ$ LINEAR $X = \pm 0.5$ $X.X = \pm 0.1$ $XXX = \pm 0.025$
 		SURFACE FINISH $0.6 \mu\text{m}$
DO NOT SCALE DRAWING		
MATERIAL: Various		
FILE NAME: MecE265_Car_Hub_Rim_Tire		


**Automark of Student Submission**

The Department of Mechanical Engineering UNIVERSITY OF ALBERTA
TITLE: <b>Hub, Rim, Tire Assembly</b>
SIZE <b>B</b> Assignment Number <b>Assignment 03</b> REV <b>2</b>
SCALE: 1:4 Mass: 175308.62 SHEET 2 OF 3

ITEM NO.	SW-File Name(File Name)	SW-Title(Title)	Material	SW-Author(Author)	QTY.
1	MecE265_Car_Hub	Hub, Disk and Calaper Assembly	Various	D.S. Nobes	1
2	dsn_Rim	Custom Low Speed Snow Rim	Pure Gold	D.S.Nobes	1
3	MecE_265_Nut	ACME HTNUT 0.500-20-D-N	Brass	Wyle E. Coyote	5
4	MecE_265_Tire	Snow Plow Car Tire	Rubber	D.S. Nobes	1

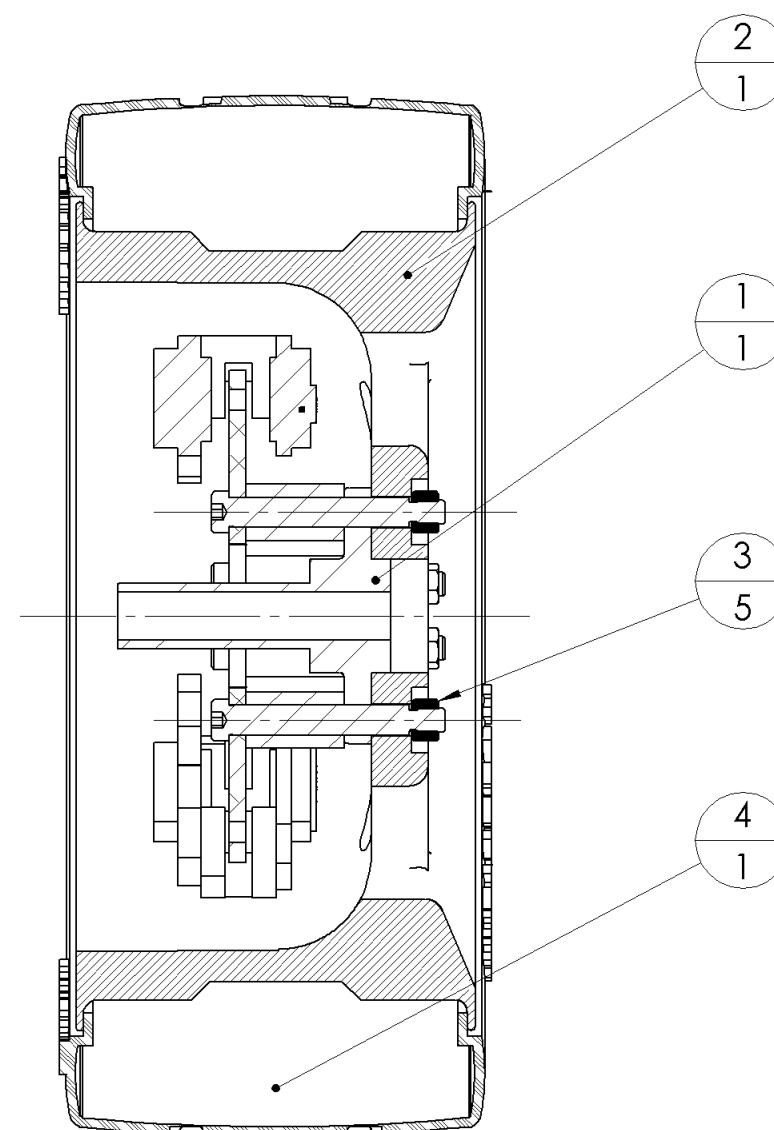


SECTION A-A

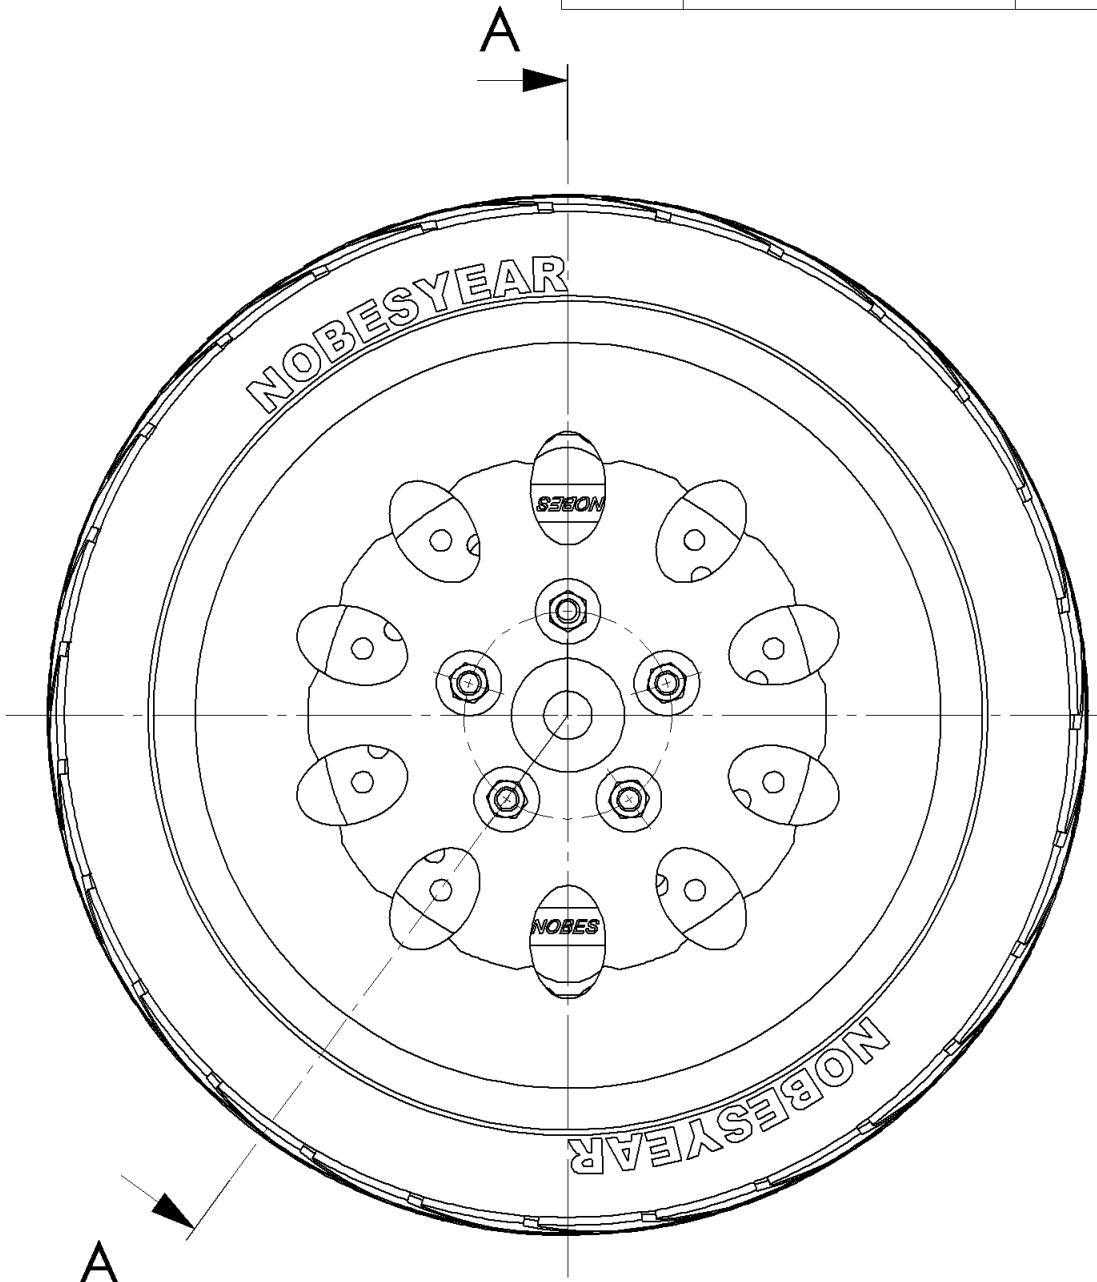

Assignment Solution



<b>MecE 265</b> Instructor: <b>Dr DS Nobes</b> Fall 2021 Comments:	UNLESS OTHERWISE SPECIFIED: DIMENSIONS ARE IN MM TOLERANCES: ANGULAR: $\pm 0.5^\circ$ LINEAR $X = \pm 0.5$ $X.X = \pm 0.1$ $XXX = \pm 0.025$ SURFACE FINISH $0.6 \mu\text{m}$ DO NOT SCALE DRAWING	DRAWN BY: <b>David S. Nobes</b> Lab Day ALL SM By <b>D.S.Nobes</b> TA Initials DSN zacha September 28, 2021 2:35:53 PM September 23, 2010 11:25:48 AM	The Department of Mechanical Engineering UNIVERSITY OF ALBERTA TITLE: <b>Hub, Rim, Tire Assembly</b>
<b>SIZE</b> <b>B</b>	Assignment Number <b>Assignment 03</b>	REV <b>2</b>	SCALE: 1:4 Mass: 175308.62 SHEET 2 OF 3
FILE NAME: <b>MecE265_Car_Hub_Rim_Tire</b>			

8 7 6 5 4 3 2 1

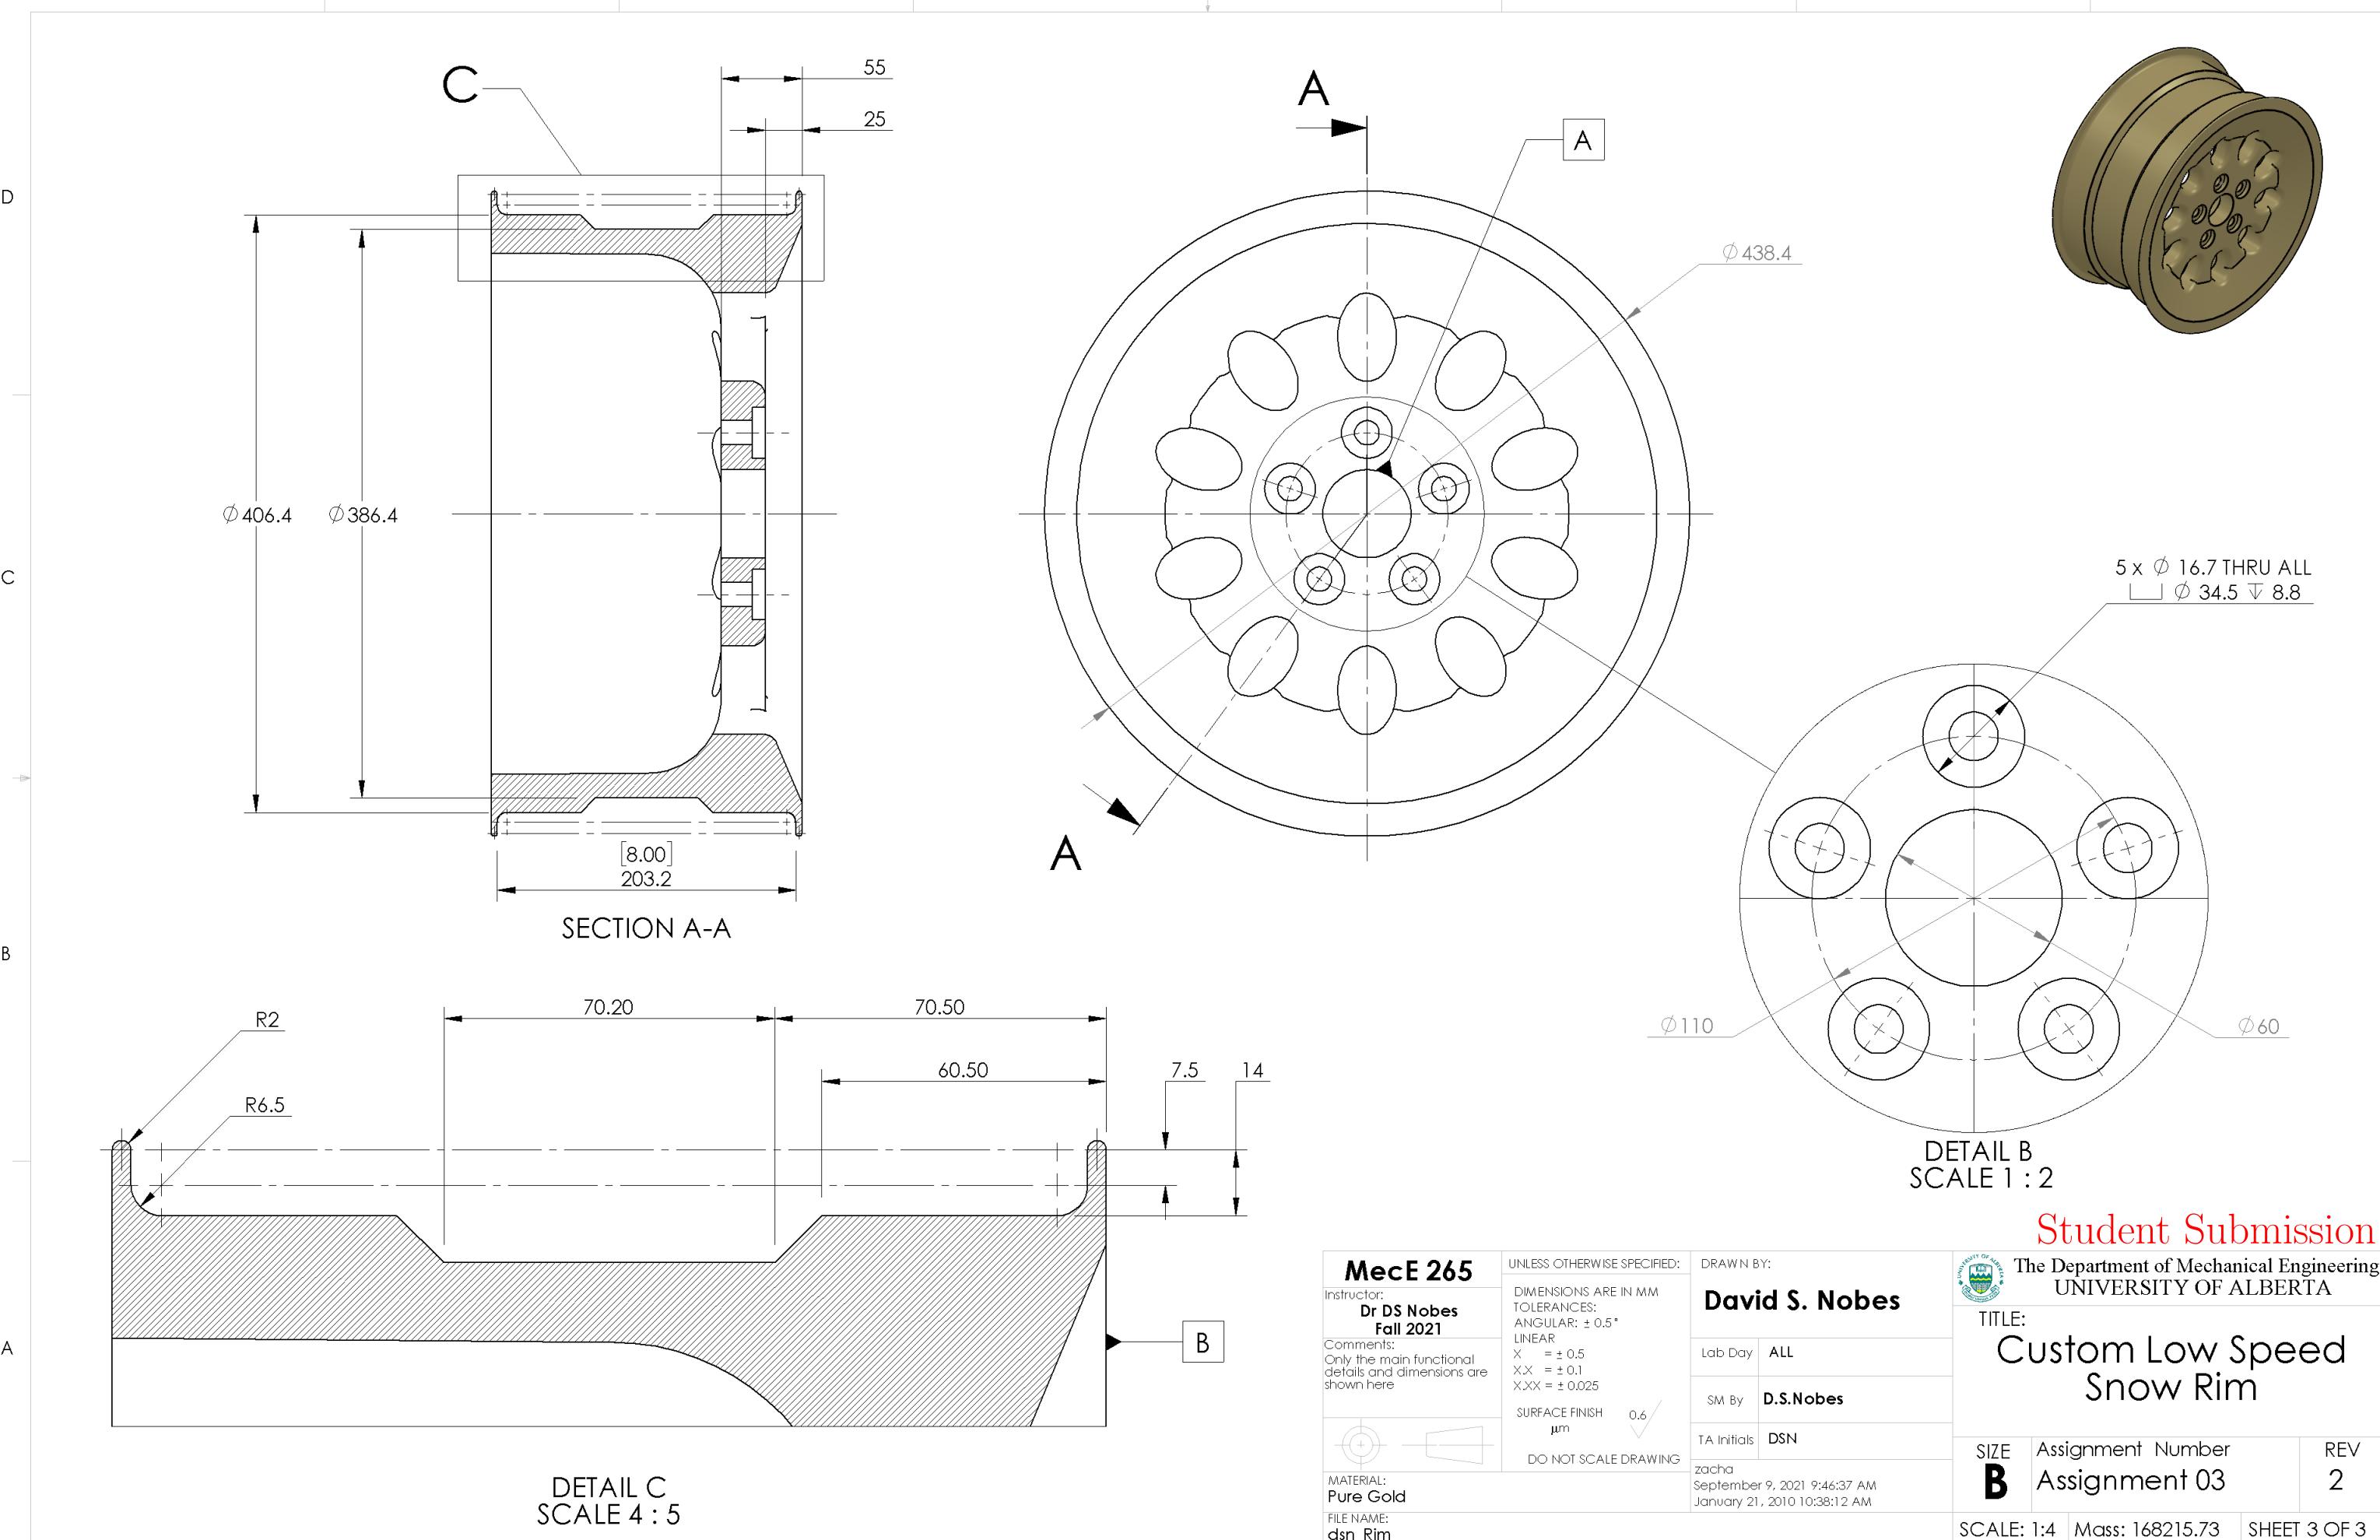


8 7 6 5 4 3 2 1

Drawing View5: 62/62  
Detail View B (1 : 2): 69/69  
Drawing View14: 22/22  
Section View A-A: 102/102  
Detail View C (4 : 5): 84/84  
SHEET TOTAL: 388/388

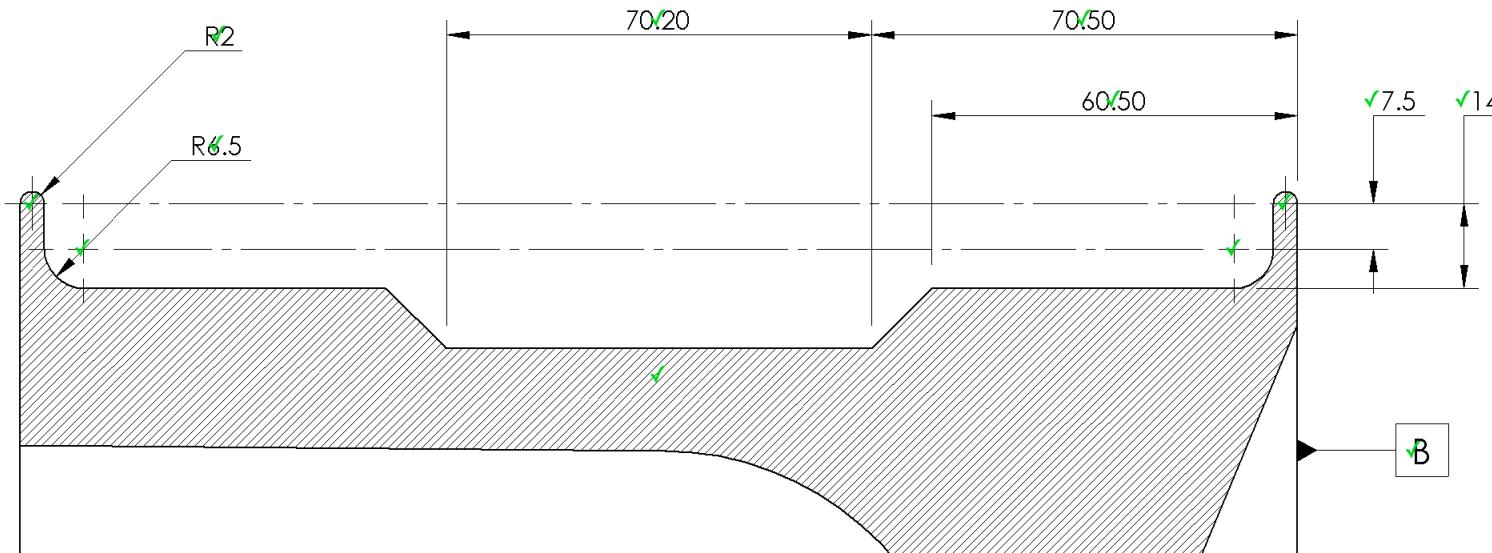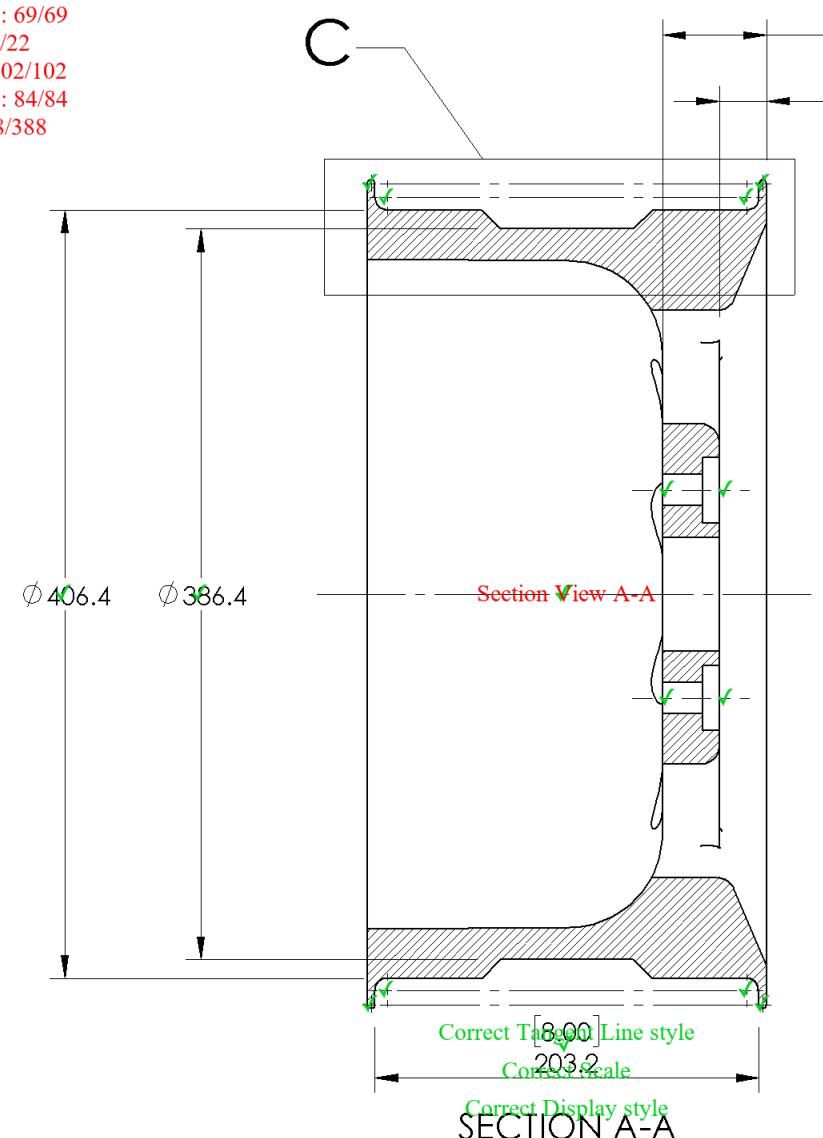

DETAIL C  
SCALE 4 : 5  
Correct Tangent Line style  
Correct Scale  
Correct Display style

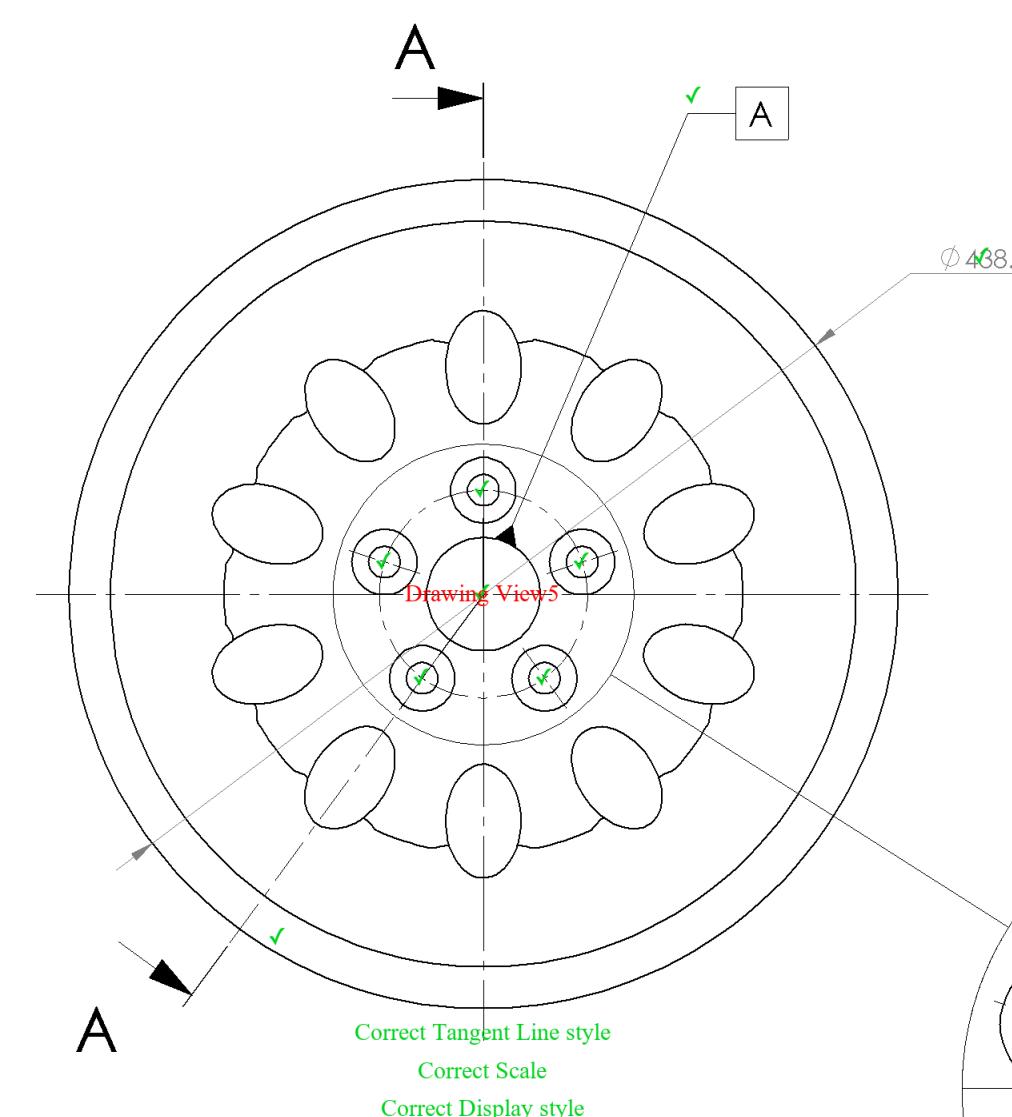


MecE 265		UNLESS OTHERWISE SPECIFIED:
Instructor:	Dr DS Nobes	
Fall 2021		TOLERANCES:
		ANGULAR: $\pm 0.5^\circ$
		LINEAR: $X = \pm 0.5$
		$X.X = \pm 0.1$
		$XXX = \pm 0.025$
		SURFACE FINISH: $0.6 \mu\text{m}$
		DO NOT SCALE DRAWING
MATERIAL:		Pure Gold
FILE NAME:		dsn_Rim

DRAWN BY:  
**David S. Nobes**  
Lab Day ALL  
SM By D.S.Nobes  
TA Initials DSN


zacha  
September 9, 2021 9:46:37 AM  
January 21, 2010 10:38:12 AM

Assignment Number  
**Assignment 03**

REV  
**2**

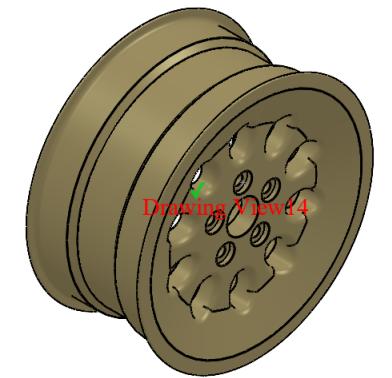

Correct Tangent Line style  
Correct Scale  
Correct Display style



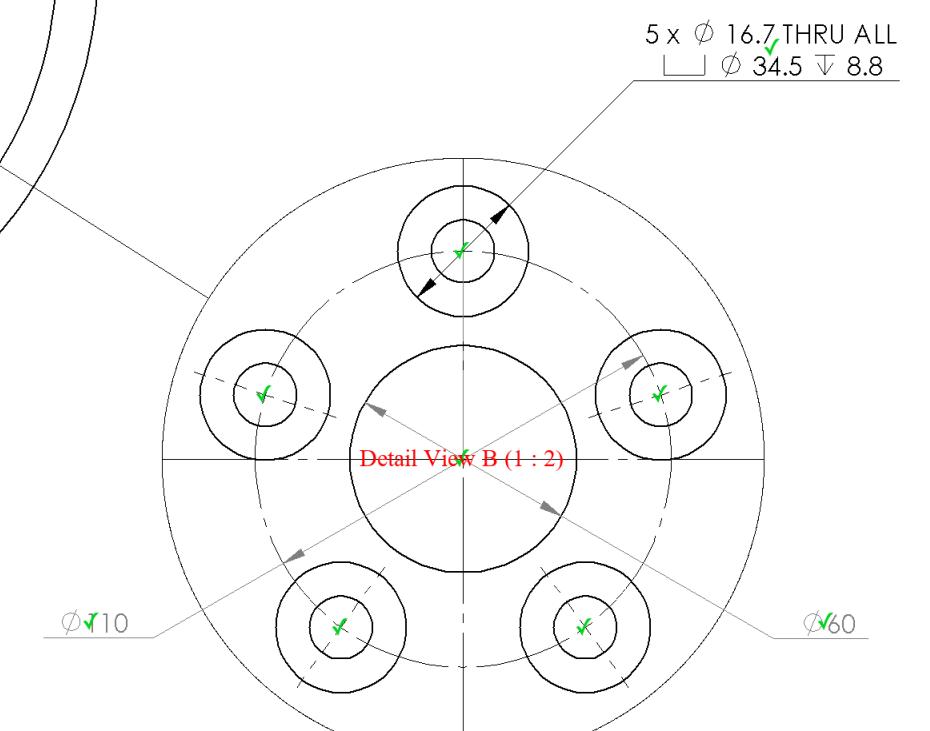


DETAIL B  
SCALE 1 : 2  
Correct Tangent Line style  
Correct Scale  
Correct Display style

Automate of Student Submission  
The Department of Mechanical Engineering  
UNIVERSITY OF ALBERTA  
TITLE:  
**Custom Low Speed Snow Rim**

SIZE **B** Assignment Number  
**Assignment 03** REV  
**2**  
SCALE: 1:4 Mass: 168215.73 SHEET 3 OF 3

8 7 6 5 4 3 2 1

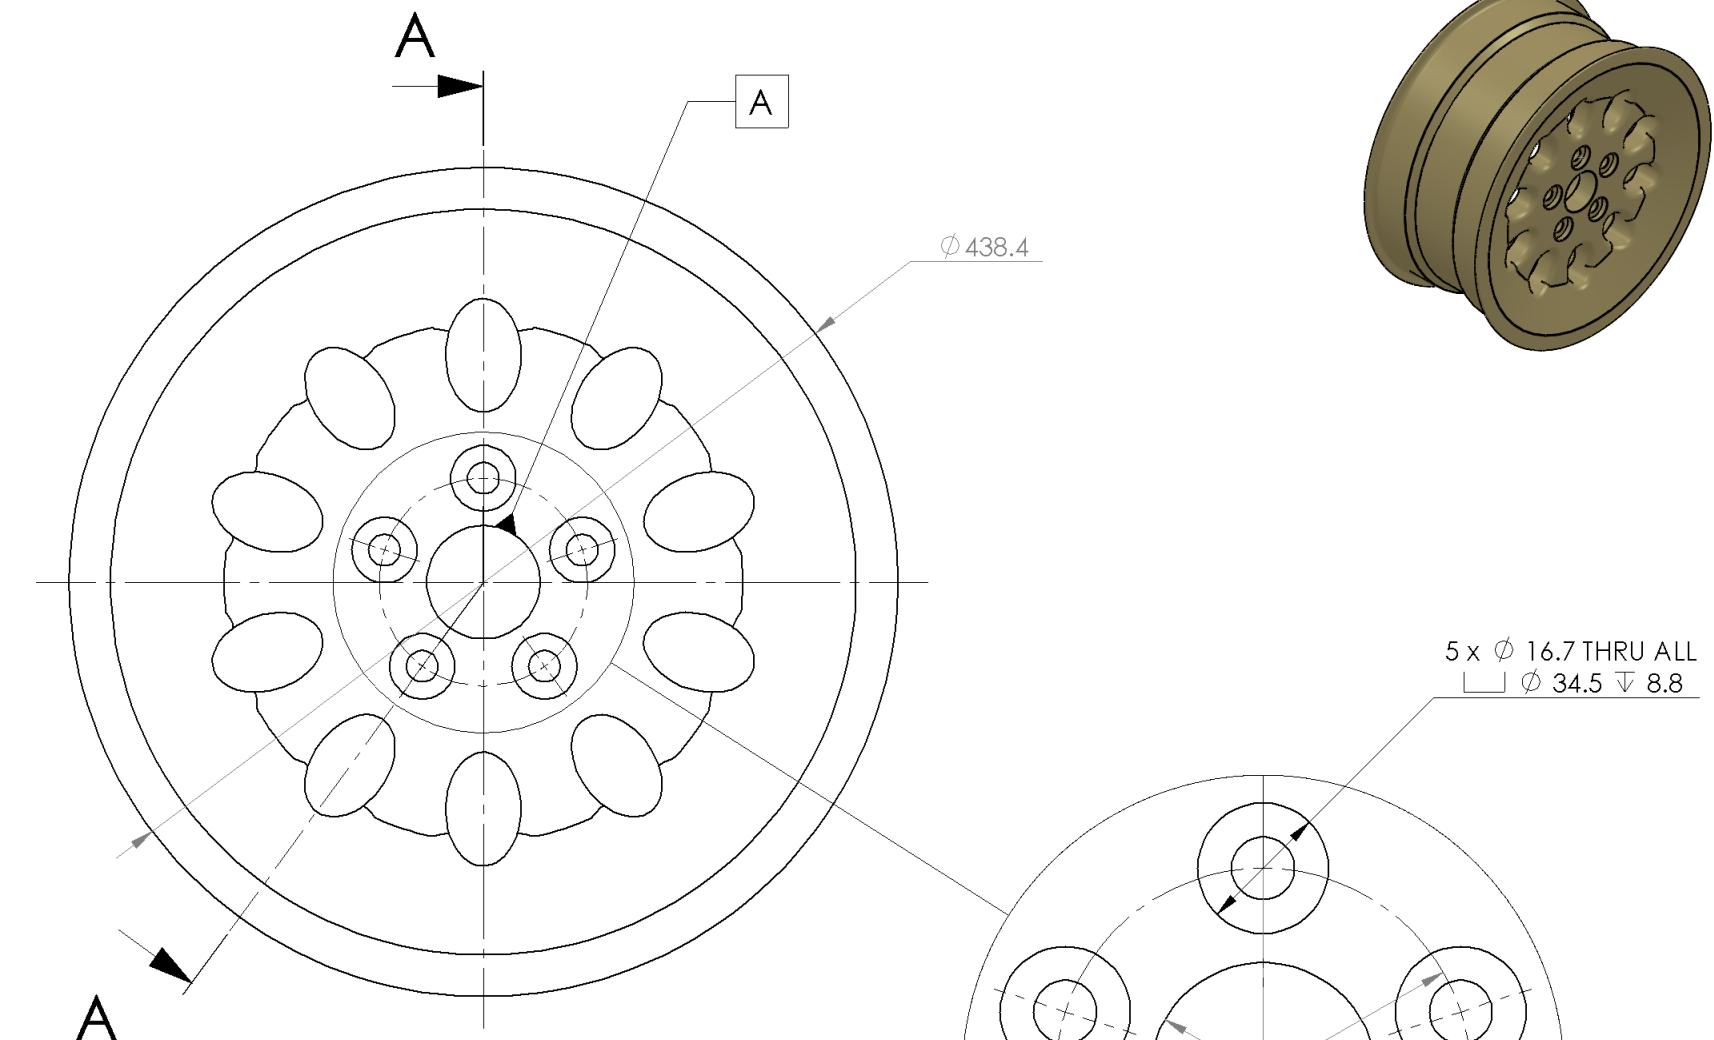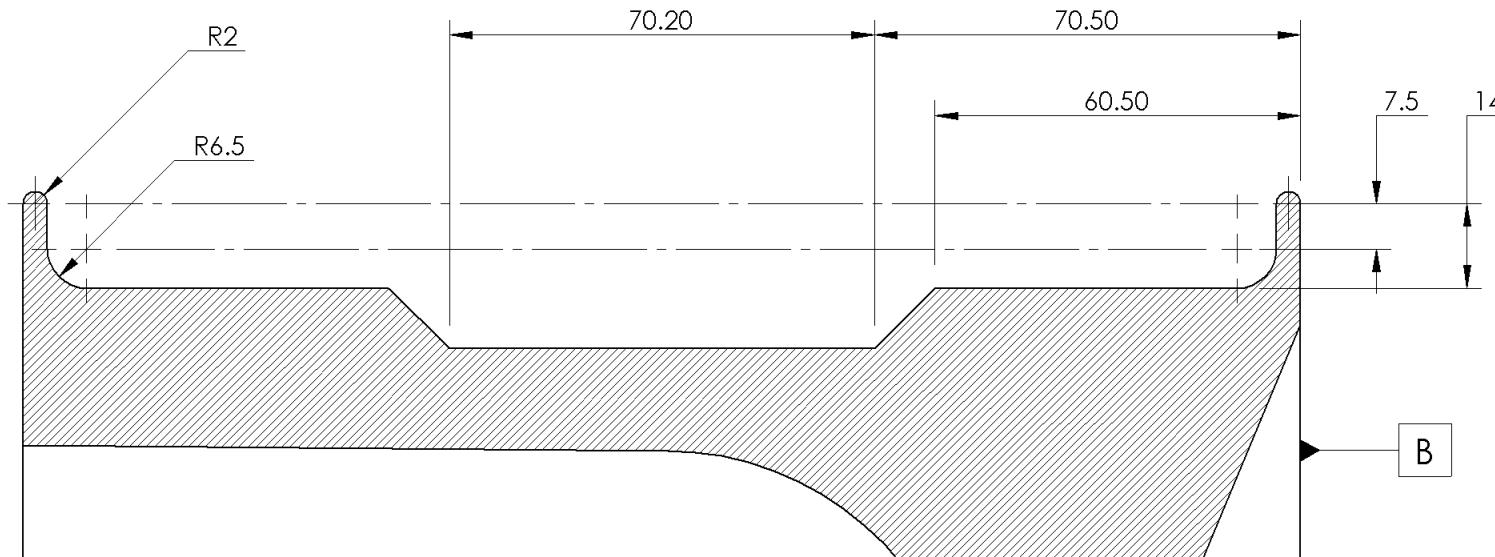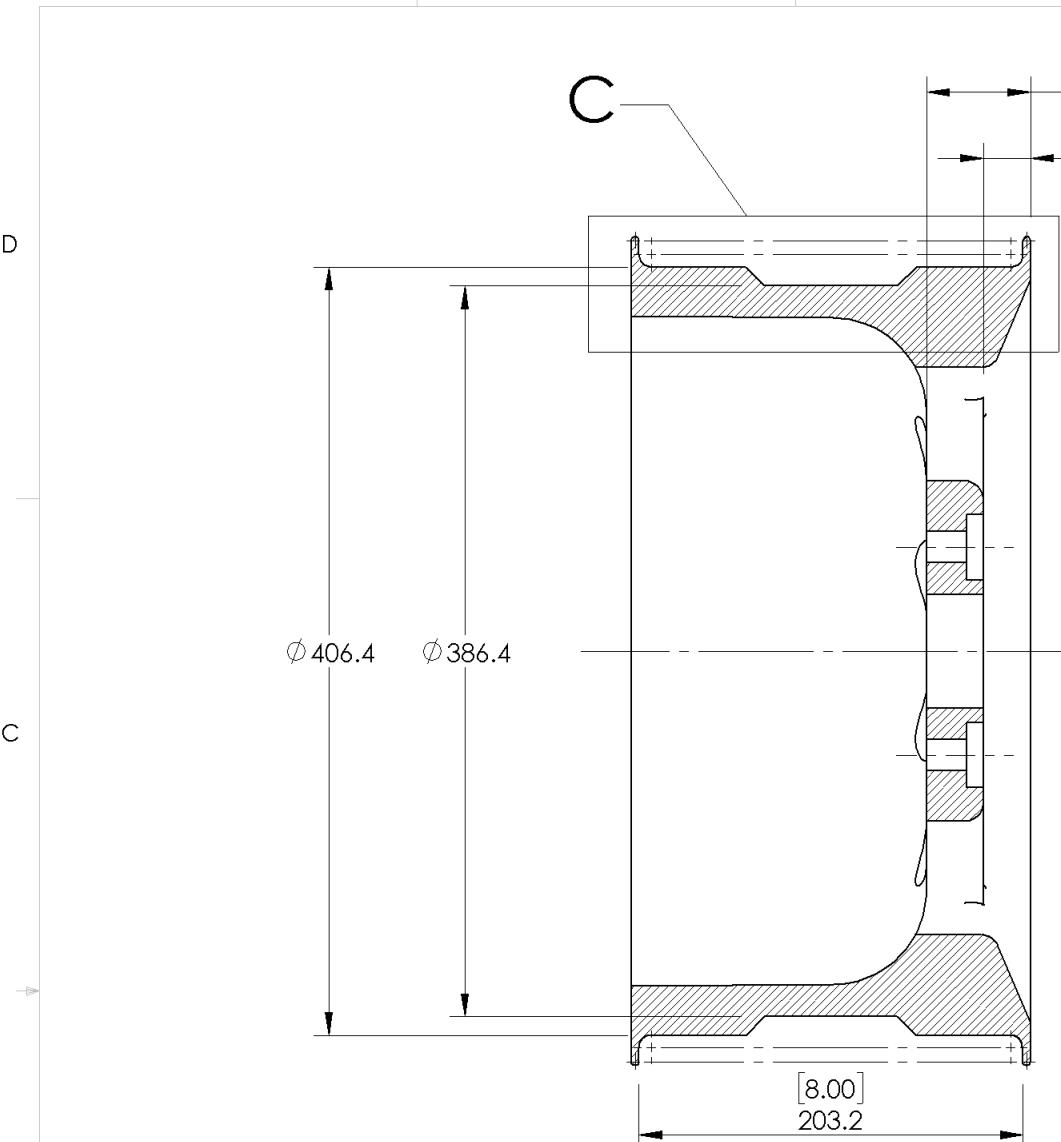

**MecE 265**  
Instructor:  
**Dr DS Nobes**  
Fall 2021  
Comments:  
Only the main functional details and dimensions are shown here

UNLESS OTHERWISE SPECIFIED:  
DIMENSIONS ARE IN MM  
TOLERANCES:  
ANGULAR:  $\pm 0.5^\circ$   
LINEAR  
 $X = \pm 0.5$   
 $X.X = \pm 0.1$   
 $XXX = \pm 0.025$

SURFACE FINISH  
 $0.6 \mu\text{m}$

DO NOT SCALE DRAWING

MATERIAL:  
Pure Gold

FILE NAME:  
dsn\_Rim

DRAWN BY:  
**David S. Nobes**

Lab Day	ALL
SM By	D.S.Nobes
TA Initials	DSN


zacha  
September 9, 2021 9:46:37 AM  
January 21, 2010 10:38:12 AM

The Department of Mechanical Engineering  
UNIVERSITY OF ALBERTA

TITLE:  
**Custom Low Speed Snow Rim**

SIZE **B** Assignment Number **Assignment 03** REV **2**

SCALE: 1:4 Mass: 168215.73 SHEET 3 OF 3

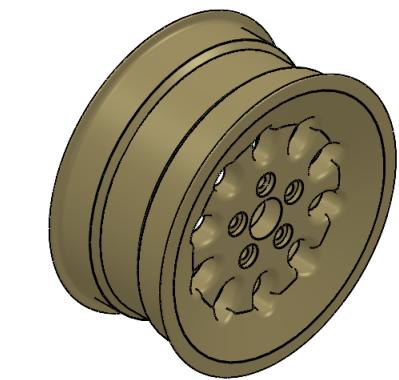

**Assignment Solution**