



Mec E 468 Numerical Simulation in Mechanical Engineering Design

AUTOMARK REPORT

Semester: Win 2022

Instructor: Prof. David S. Nobes

Student Name:

Assignment: Assignment No 1

PROCESSING DATE: July 5, 2022

AUTOMark Assessment Grade: 269 out of 290

AUTOMark Recommended Grade: 93 out of 100

NOTE: This grade is preliminary only and needs to be confirmed.

The following pages include each of the drawings in the following order:

- Your submission
- Your submission marked by AutoMARK
- The solution

Other important points:

- Examples are given on eClass of how to interpret the mark-up symbols used by AUTOMark.
- If you have any questions, discuss with you TA in the next lab time.

DRAWING CREATION DATE: 23-Dec-2020 16:08:23

DRAWING LAST SAVE DATE: 29-Jun-2022 11:47:34

MODEL CREATION DATE: 09-Jun-2016 09:39:47

MODEL LAST SAVE DATE: 13-Aug-2021 16:01:41






AutoMARK details:

- Sheetnames should contain only alphabetical characters
- Weights of feature properties are set by the marker
- AutoMARK v 4.0 software written and designed by Owen Stadlwieser

AutoMARK Criterion (The weights of these criterion are decided by the marker):

- DRAWING: SheetOrder, ExtraSheets
- SHEET: SheetPaperSize, SheetScale, SheetTemplate, SheetExtraBOMS, SheetExtraViews, SheetViewTypes, SheetIntersectingBallons
- BILLOFMATERIALS: BOMTableType, BOMNumberColumns, BOMNumberRows, BOM-Position, BOMTableHeight, BOMTableWidth, BOMFontType, BOMFontSize
- VIEW: ViewScale, ViewDisplayStyle, ViewExtraDimension, ViewPosition, ViewExtra-CenterMarks, ViewMass, ViewMaterial, ViewExtraDatums, ViewWrongProjection, ViewEx-traCenterlines
- DIMENSION: DimensionDangling, DimensionWrongView, DimensionPosition, Dimen-sionArrowSide, DimensionValue, DimensionBadText
- CENTERLINE: CenterlineDangling, CenterlinePosition
- CENTERMARK: CentermarkDangling, CentermarkPosition, CentermarkShowlines, Cen-termarkAngle, CentermarkConnectionLines, CentermarkExtensions, CentermarkGap, CentermarkSize, CentermarkGroupedCorrectly
- DATUM: DatumDangling, DatumWrongView, DatumPosition, DatumLabel, DatumDis-playStyle, DatumFilledTriangle
- Ballon: BallonDangling, BallonPosition

Symbol/Colour	Meaning
✓	No deductions on feature
Colour	Incorrect value
Colour	Miscellaneous error
Colour	Incorrect Position
Colour	Unrecognized feature
Colour	Missing feature
?	Feature not found on key

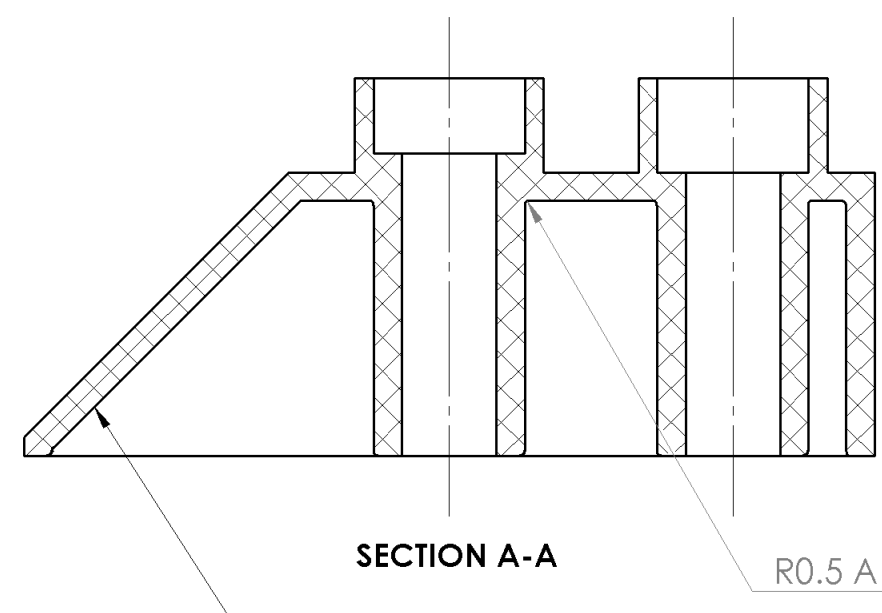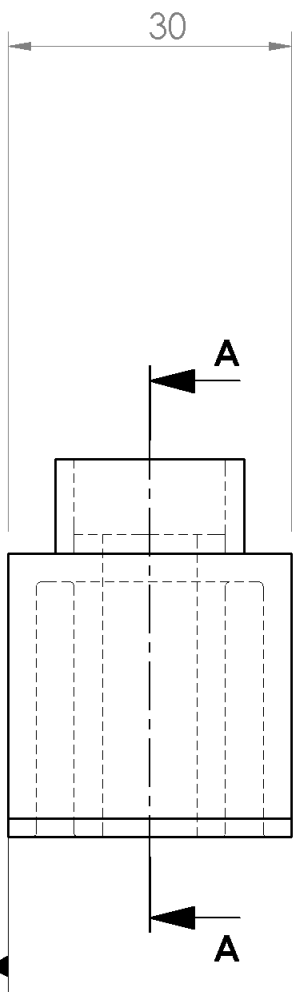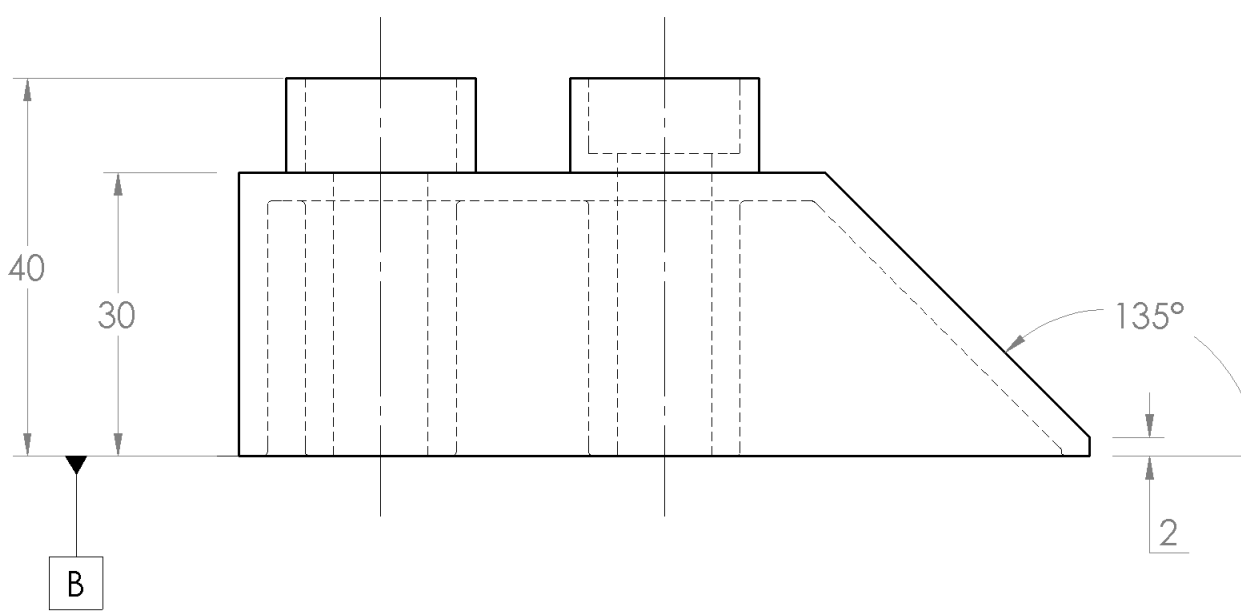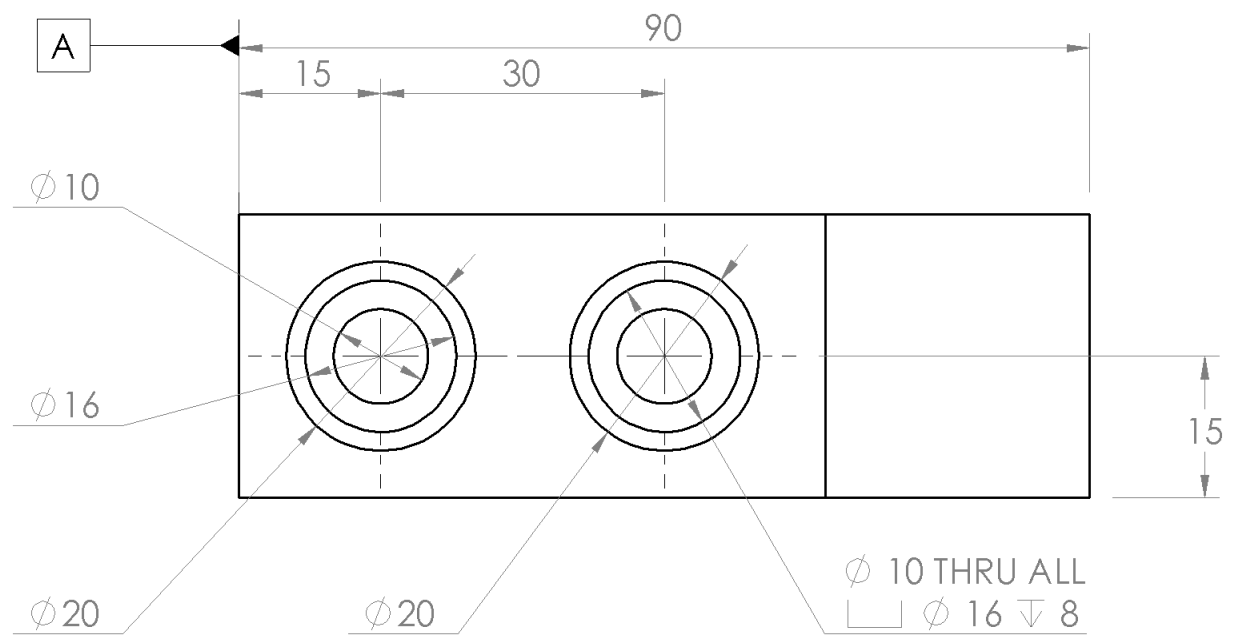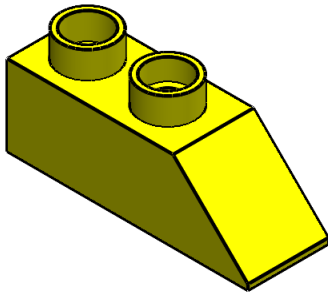

MecE 265
Instructor: **Dr. Nobes F2021**
Comments: This is my first assignment in MecE 265, but is Assignment ZERO!

UNLESS OTHERWISE SPECIFIED:
DIMENSIONS ARE IN MM
TOLERANCES:
ANGULAR: $\pm 0.5^\circ$
LINEAR
X = ± 0.5
X.X = ± 0.1
X.XX = ± 0.025
SURFACE FINISH μm 0.6
DO NOT SCALE DRAWING

NOTE: Shell All Internal 3mm

Lab Day BOTH
SM By **D.S.Nobes**
TA Initials DSN
zacha
August 13, 2021 4:01:41 PM
June 9, 2016 9:39:47 AM






Student Submission
The Department of Mechanical Engineering
UNIVERSITY OF ALBERTA

TITLE: **The LEGO BRICK**

SIZE **B** Assignment Number Assignment ZERO REV 1

SCALE: 5:4 Mass: 32.36 SHEET 1 OF 1

Drawing View1: 47/53
Drawing View2: 81/82
Drawing View3: 25/32
Drawing View4: 22/22
Section View A-A: 28/35
SHEET TOTAL: 252/273

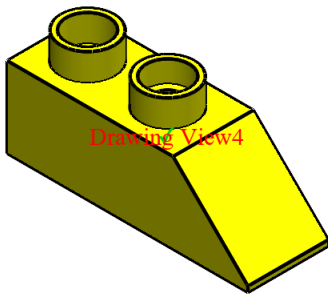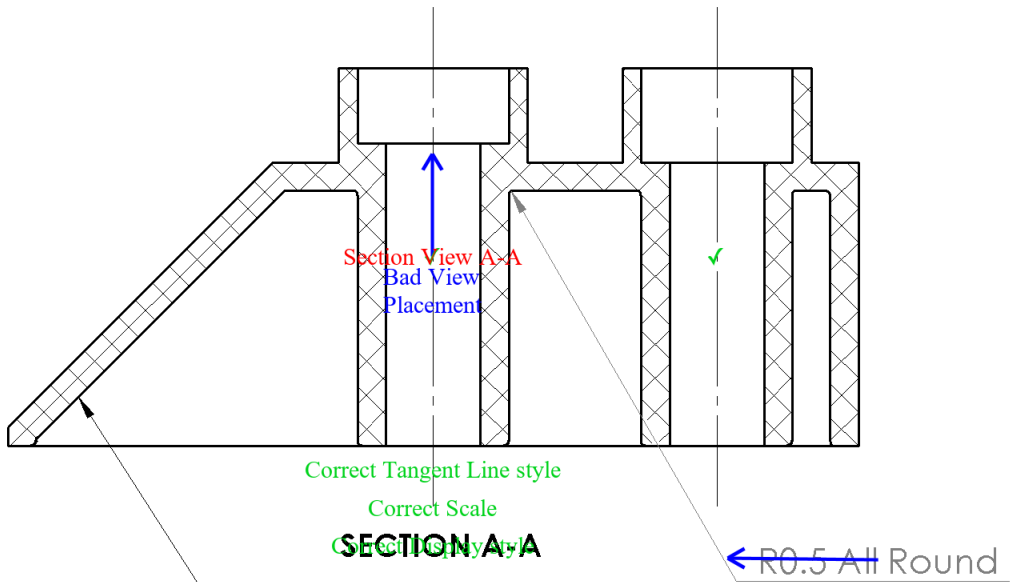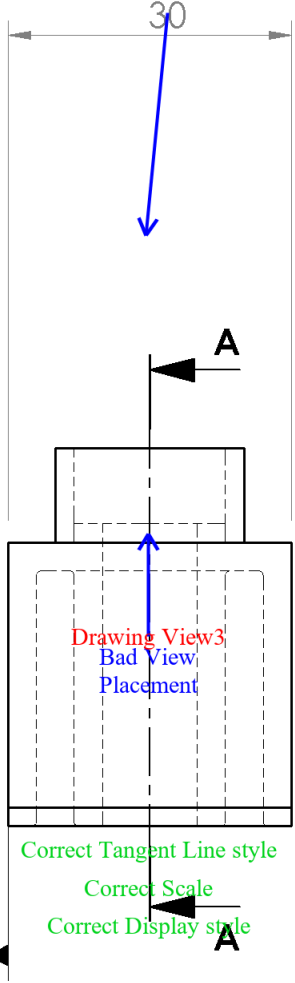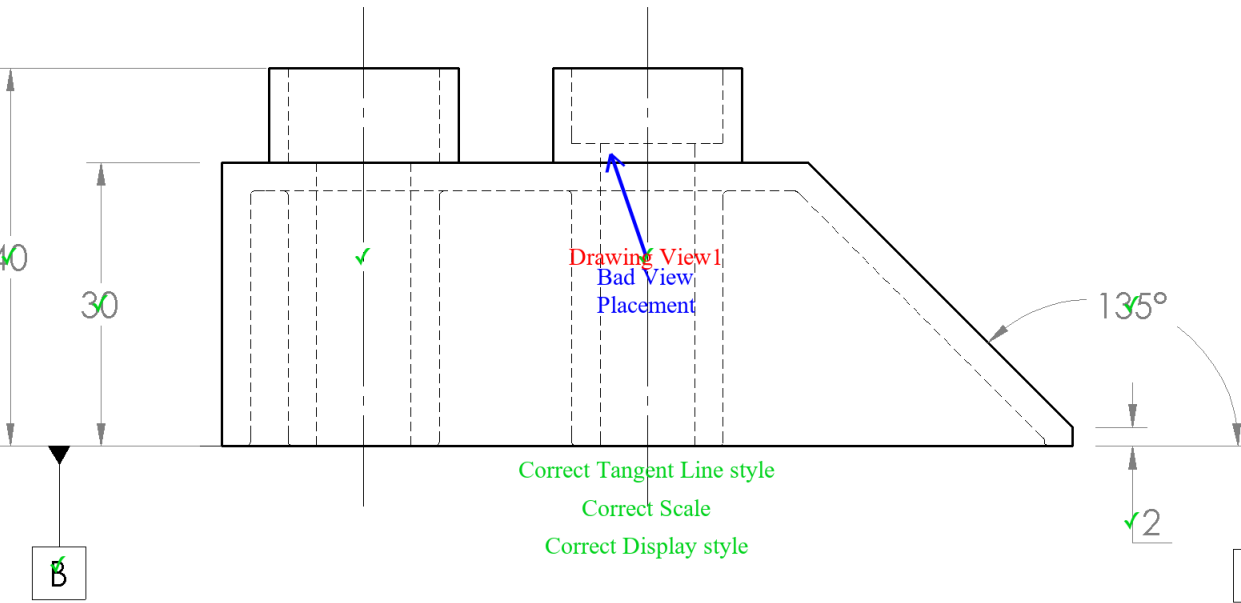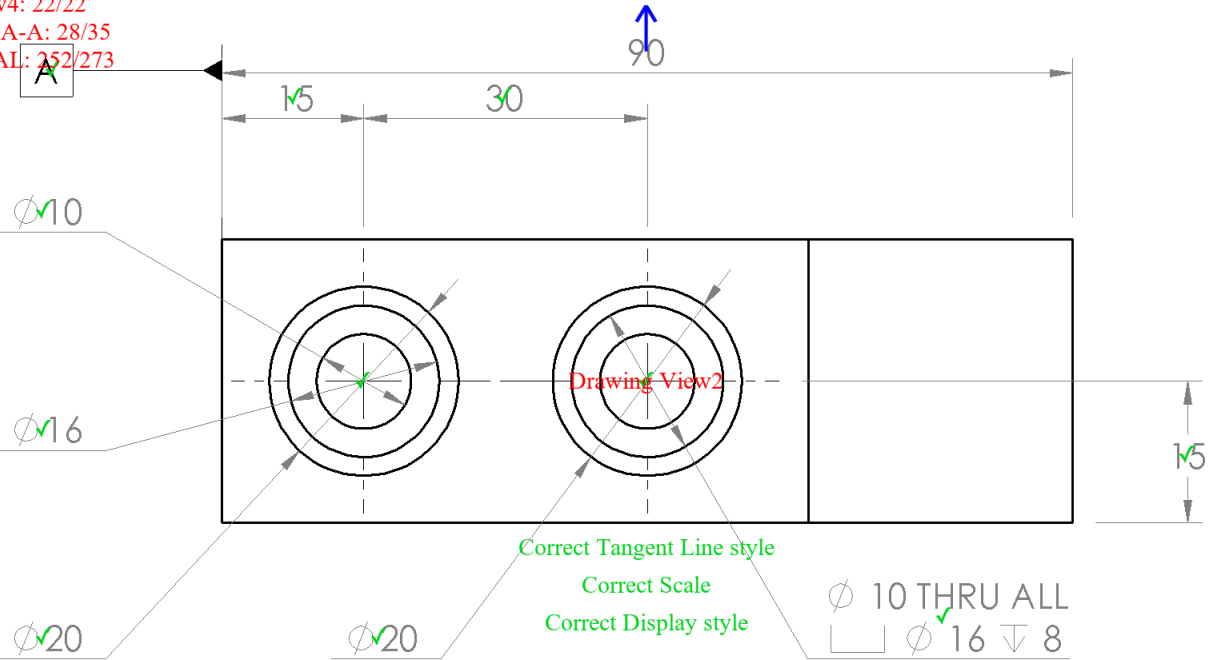

Correct Tangent Line style
Correct Scale
Correct Display style

MecE 265

Instructor:
Dr. Nobes
F2021

Comments:
This is my first assignment in
MecE 265, but is Assignment
ZERO!

MATERIAL:
ABS

FILE NAME:
LEGO_BRICK_dnobes

UNLESS OTHERWISE SPECIFIED:

DIMENSIONS ARE IN MM
TOLERANCES:
ANGULAR: $\pm 0.5^\circ$
LINEAR
X = ± 0.5
X.X = ± 0.1
X.XX = ± 0.025
SURFACE FINISH
 μm 0.6
DO NOT SCALE DRAWING

DRAWN BY:
David S. Nobes
Lab Day: BOTH
SM By: **D.S.Nobes**
TA Initials: DSN
zacha
August 13, 2021 4:01:41 PM
June 9, 2016 9:39:47 AM

TITLE:
The LEGO BRICK


SIZE **B** Assignment Number
Assignment ZERO

SCALE: 5:4 Mass: 32.36



REV
1

SHEET 1 OF 1

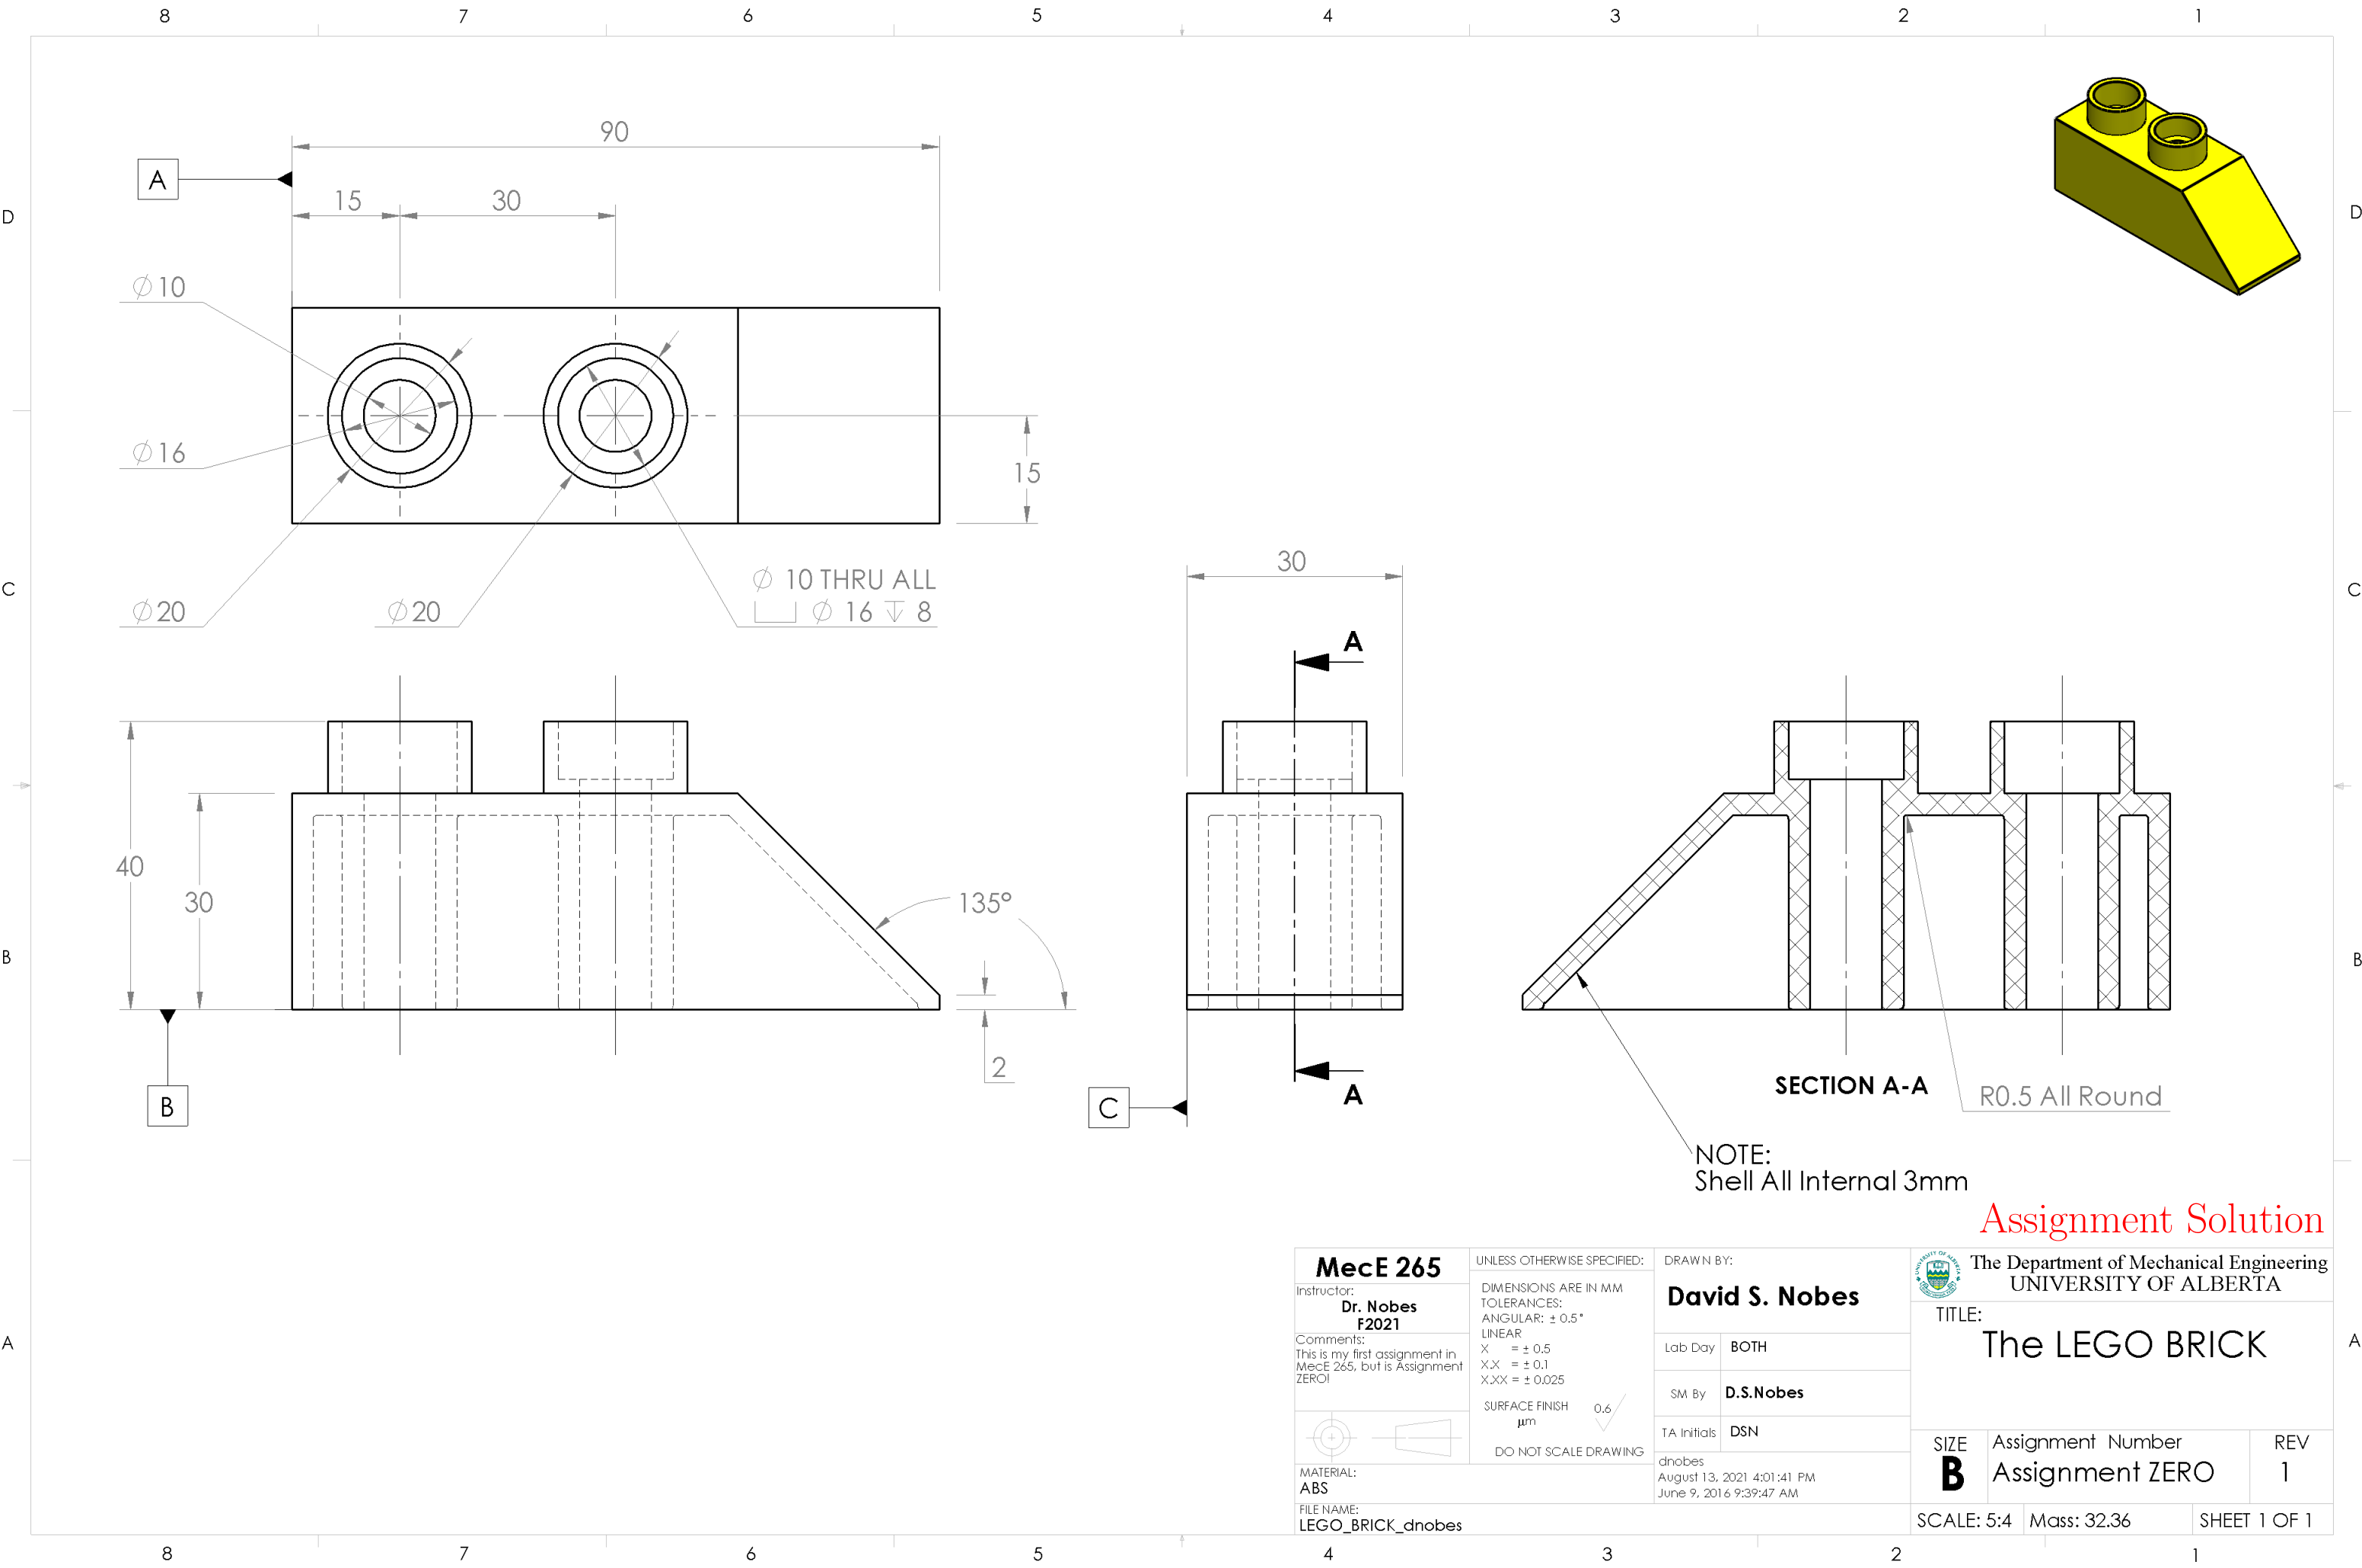NOTE: Shell All Internal 3mm
Automark of Student Submission



Assignment Solution

<div>MecE 265</div> <div>Instructor: Dr. Nobes F2021</div> <div>Comments: This is my first assignment in MecE 265, but is Assignment ZERO!</div> <div></div> <div>MATERIAL: ABS</div> <div>FILE NAME: LEGO_BRICK_dnobes</div>		<div>UNLESS OTHERWISE SPECIFIED:</div> <div>DIMENSIONS ARE IN MM TOLERANCES: ANGULAR: ± 0.5° LINEAR X = ± 0.5 X.X = ± 0.1 X.XX = ± 0.025</div> <div>SURFACE FINISH μm 0.6</div> <div>DO NOT SCALE DRAWING</div>		<div>DRAWN BY:</div> <div>David S. Nobes</div> <table><tr><td>Lab Day</td><td>BOTH</td></tr><tr><td>SM By</td><td>D.S.Nobes</td></tr><tr><td>TA Initials</td><td>DSN</td></tr></table> <div>dnobes August 13, 2021 4:01:41 PM June 9, 2016 9:39:47 AM</div>		Lab Day	BOTH	SM By	D.S.Nobes	TA Initials	DSN	<div>The Department of Mechanical Engineering UNIVERSITY OF ALBERTA</div> <div>TITLE: The LEGO BRICK</div> <table><tr><td>SIZE B</td><td>Assignment Number Assignment ZERO</td><td>REV 1</td></tr><tr><td colspan="2">SCALE: 5:4</td><td>Mass: 32.36</td></tr><tr><td colspan="2"></td><td>SHEET 1 OF 1</td></tr></table>		SIZE B	Assignment Number Assignment ZERO	REV 1	SCALE: 5:4		Mass: 32.36			SHEET 1 OF 1
Lab Day	BOTH																					
SM By	D.S.Nobes																					
TA Initials	DSN																					
SIZE B	Assignment Number Assignment ZERO	REV 1																				
SCALE: 5:4		Mass: 32.36																				
		SHEET 1 OF 1																				