



Mec E 468 Numerical Simulation in Mechanical Engineering Design

AUTOMARK REPORT

Semester: Win 2022

Instructor: Prof. David S. Nobes

Student Name:

Assignment: Assignment No 1

PROCESSING DATE: June 30, 2022

AUTOMark Assessment Grade: 278 out of 290

AUTOMark Recommended Grade: 96 out of 100

NOTE: This grade is preliminary only and needs to be confirmed.

The following pages include each of the drawings in the following order:

- Your submission
- Your submission marked by AutoMARK
- The solution

Other important points:

- Examples are given on eClass of how to interpret the mark-up symbols used by AUTOMark.
- If you have any questions, discuss with you TA in the next lab time.

DRAWING CREATION DATE: 23-Dec-2020 16:08:23

DRAWING LAST SAVE DATE: 29-Jun-2022 11:46:15

MODEL CREATION DATE: 09-Jun-2016 09:39:47

MODEL LAST SAVE DATE: 13-Aug-2021 16:01:41


AutoMARK details:

- Sheetnames should contain only alphabetical characters
- Weights of feature properties are set by the marker
- AutoMARK v 4.0 software written and designed by Owen Stadlwieser

AutoMARK Criterion (The weights of these criterion are decided by the marker):

- DRAWING: SheetOrder, ExtraSheets
- SHEET: SheetPaperSize, SheetScale, SheetTemplate, SheetExtraBOMS, SheetExtraViews, SheetViewTypes, SheetIntersectingBallons
- BILLOFMATERIALS: BOMTableType, BOMNumberColumns, BOMNumberRows, BOM-Position, BOMTableHeight, BOMTableWidth, BOMFontType, BOMFontSize
- VIEW: ViewScale, ViewDisplayStyle, ViewExtraDimension, ViewPosition, ViewExtra-CenterMarks, ViewMass, ViewMaterial, ViewExtraDatums, ViewWrongProjection, ViewEx-traCenterlines
- DIMENSION: DimensionDangling, DimensionWrongView, DimensionPosition, Dimen-sionArrowSide, DimensionValue, DimensionBadText
- CENTERLINE: CenterlineDangling, CenterlinePosition
- CENTERMARK: CentermarkDangling, CentermarkPosition, CentermarkShowlines, Cen-termarkAngle, CentermarkConnectionLines, CentermarkExtensions, CentermarkGap, CentermarkSize, CentermarkGroupedCorrectly
- DATUM: DatumDangling, DatumWrongView, DatumPosition, DatumLabel, DatumDis-playStyle, DatumFilledTriangle
- Ballon: BallonDangling, BallonPosition

Symbol/Colour	Meaning
✓	No deductions on feature
Colour	Incorrect value
Colour	Miscellaneous error
Colour	Incorrect Position
Colour	Unrecognized feature
Colour	Missing feature
?	Feature not found on key

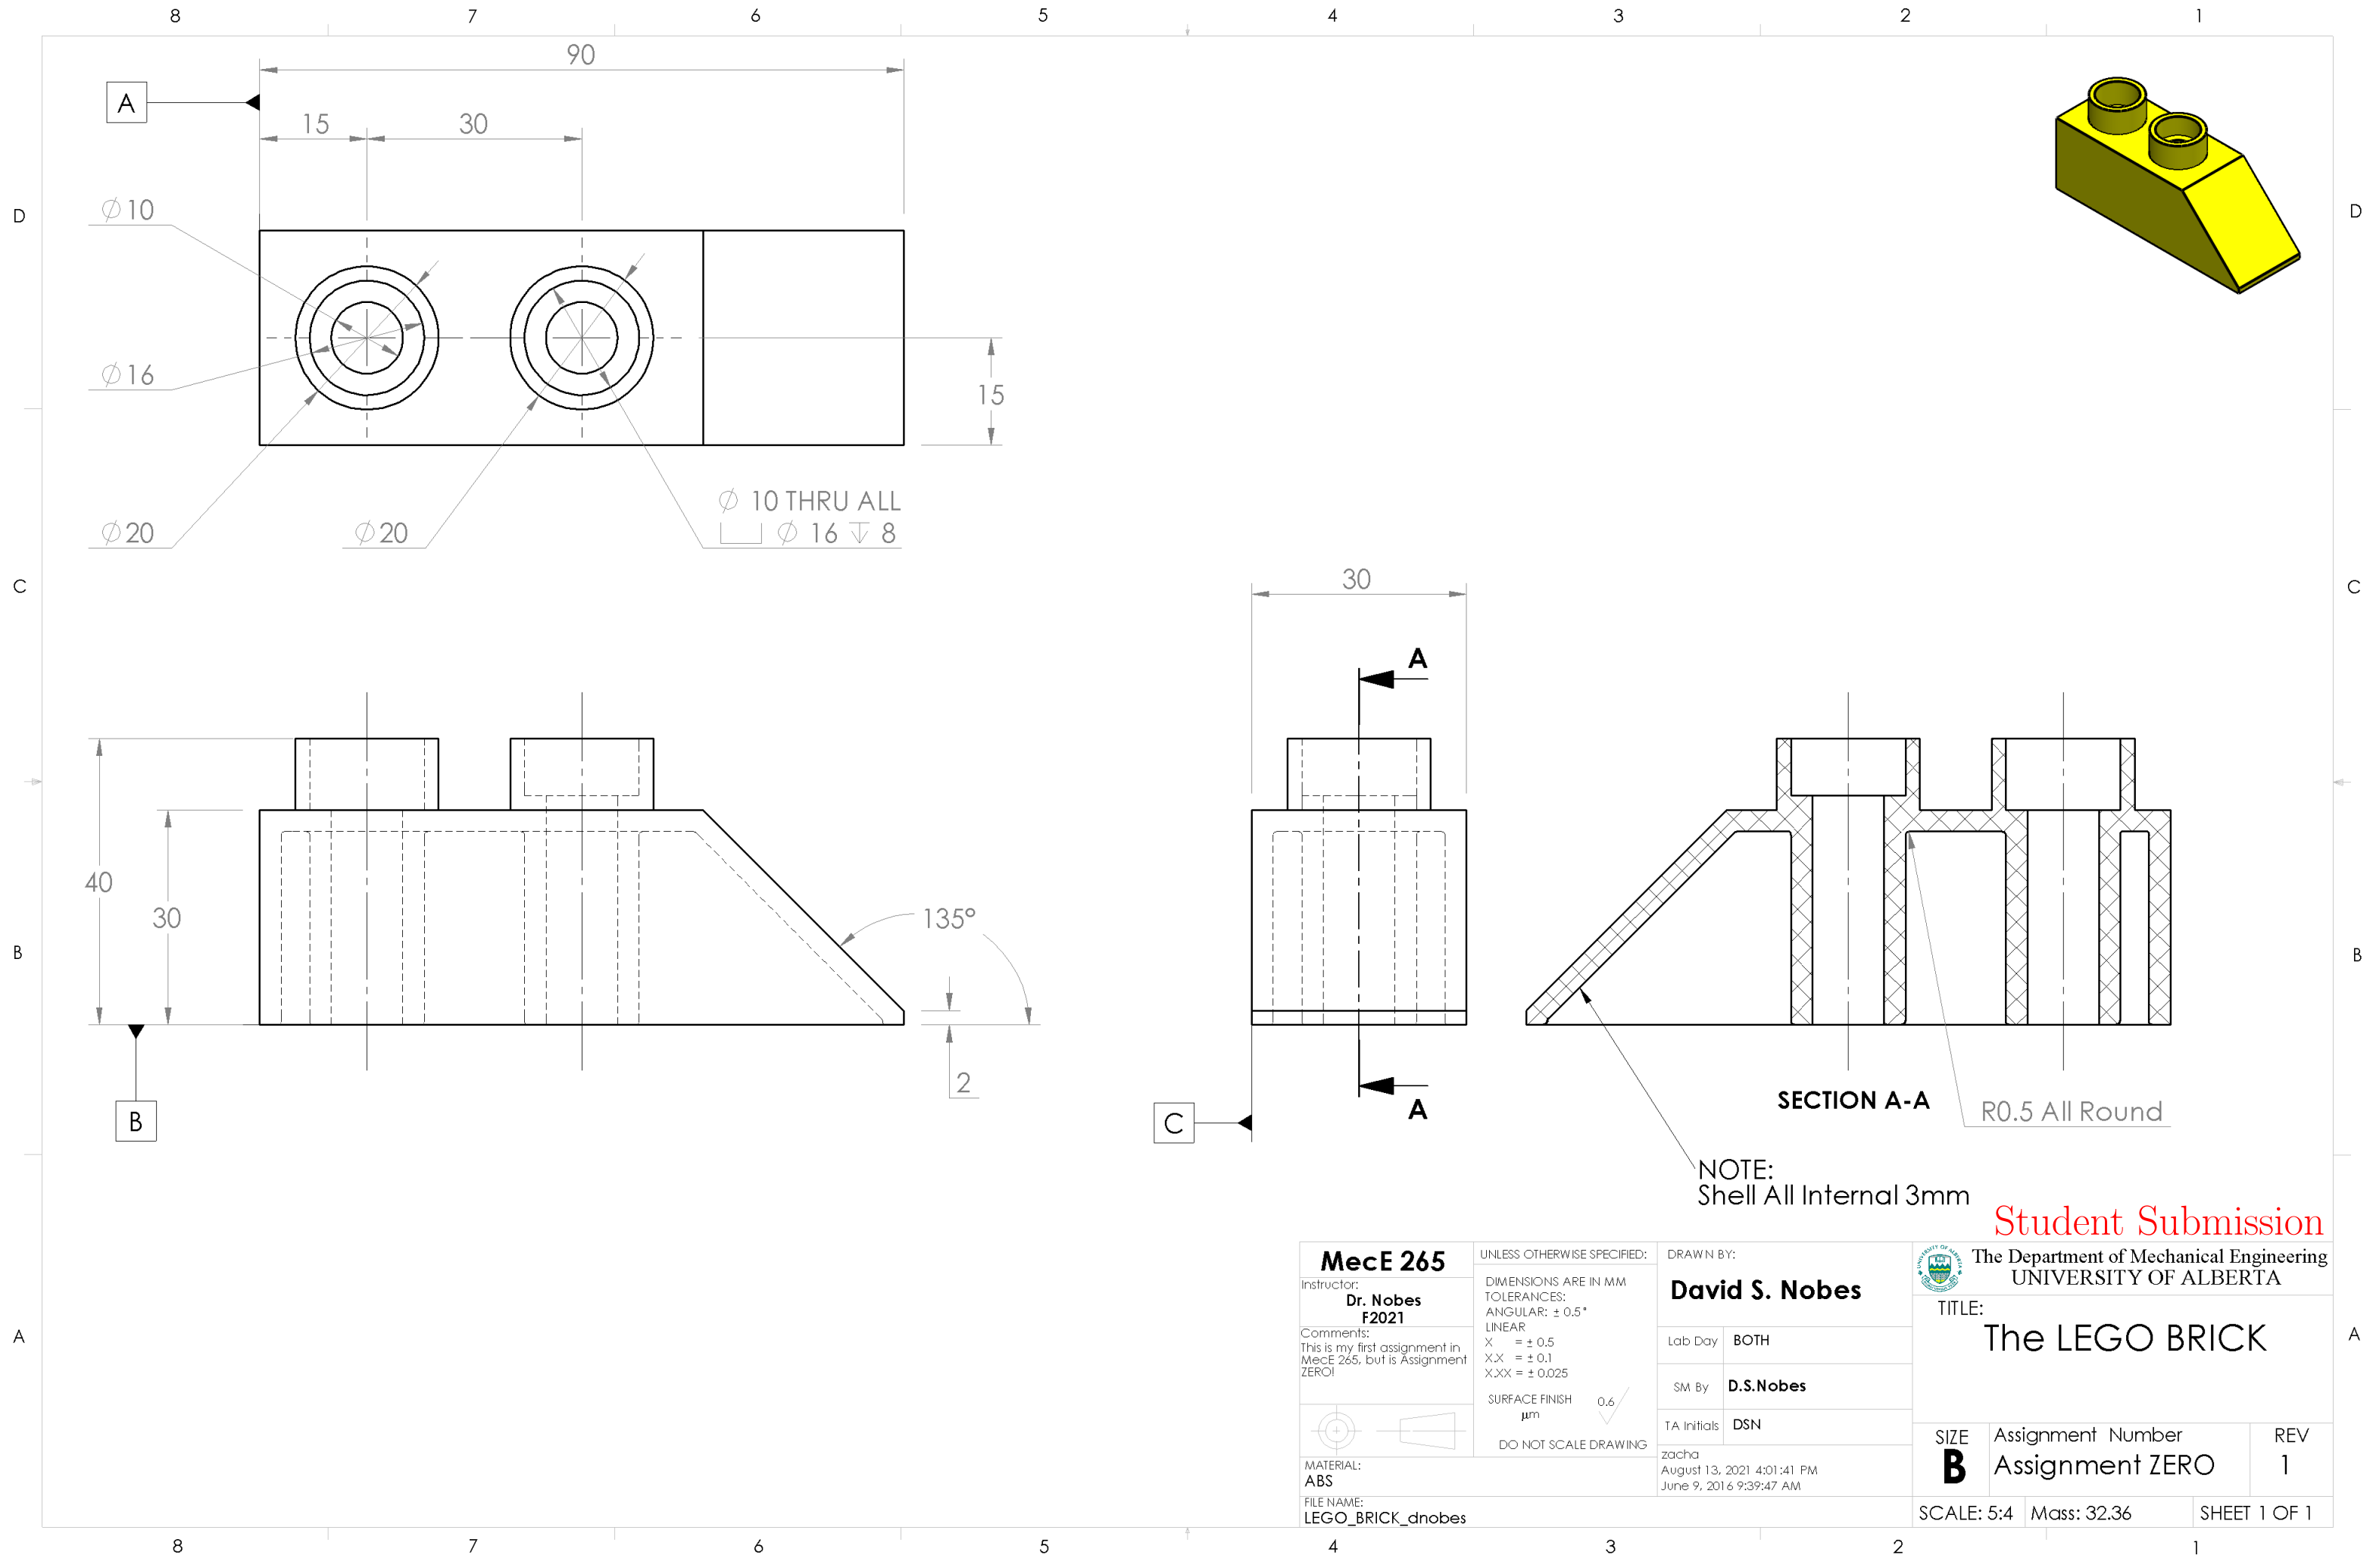

MecE 265

Instructor:
Dr. Nobes
F2021

Comments:
This is my first assignment in
MecE 265, but is Assignment
ZERO!



MATERIAL:
ABS

FILE NAME:
LEGO_BRICK_dnobes

UNLESS OTHERWISE SPECIFIED:

DIMENSIONS ARE IN MM
TOLERANCES:
ANGULAR: $\pm 0.5^\circ$
LINEAR
X = ± 0.5
X.X = ± 0.1
X.XX = ± 0.025

SURFACE FINISH
 μm 0.6

DO NOT SCALE DRAWING

DRAWN BY:

David S. Nobes

Lab Day

BOTH

SM By

D.S.Nobes

TA Initials

DSN

zacha
August 13, 2021 4:01:41 PM
June 9, 2016 9:39:47 AM



The Department of Mechanical Engineering
UNIVERSITY OF ALBERTA

TITLE:

The LEGO BRICK

SIZE

B

Assignment Number

Assignment ZERO

REV


1

SCALE: 5:4

Mass: 32.36

SHEET 1 OF 1

Student Submission

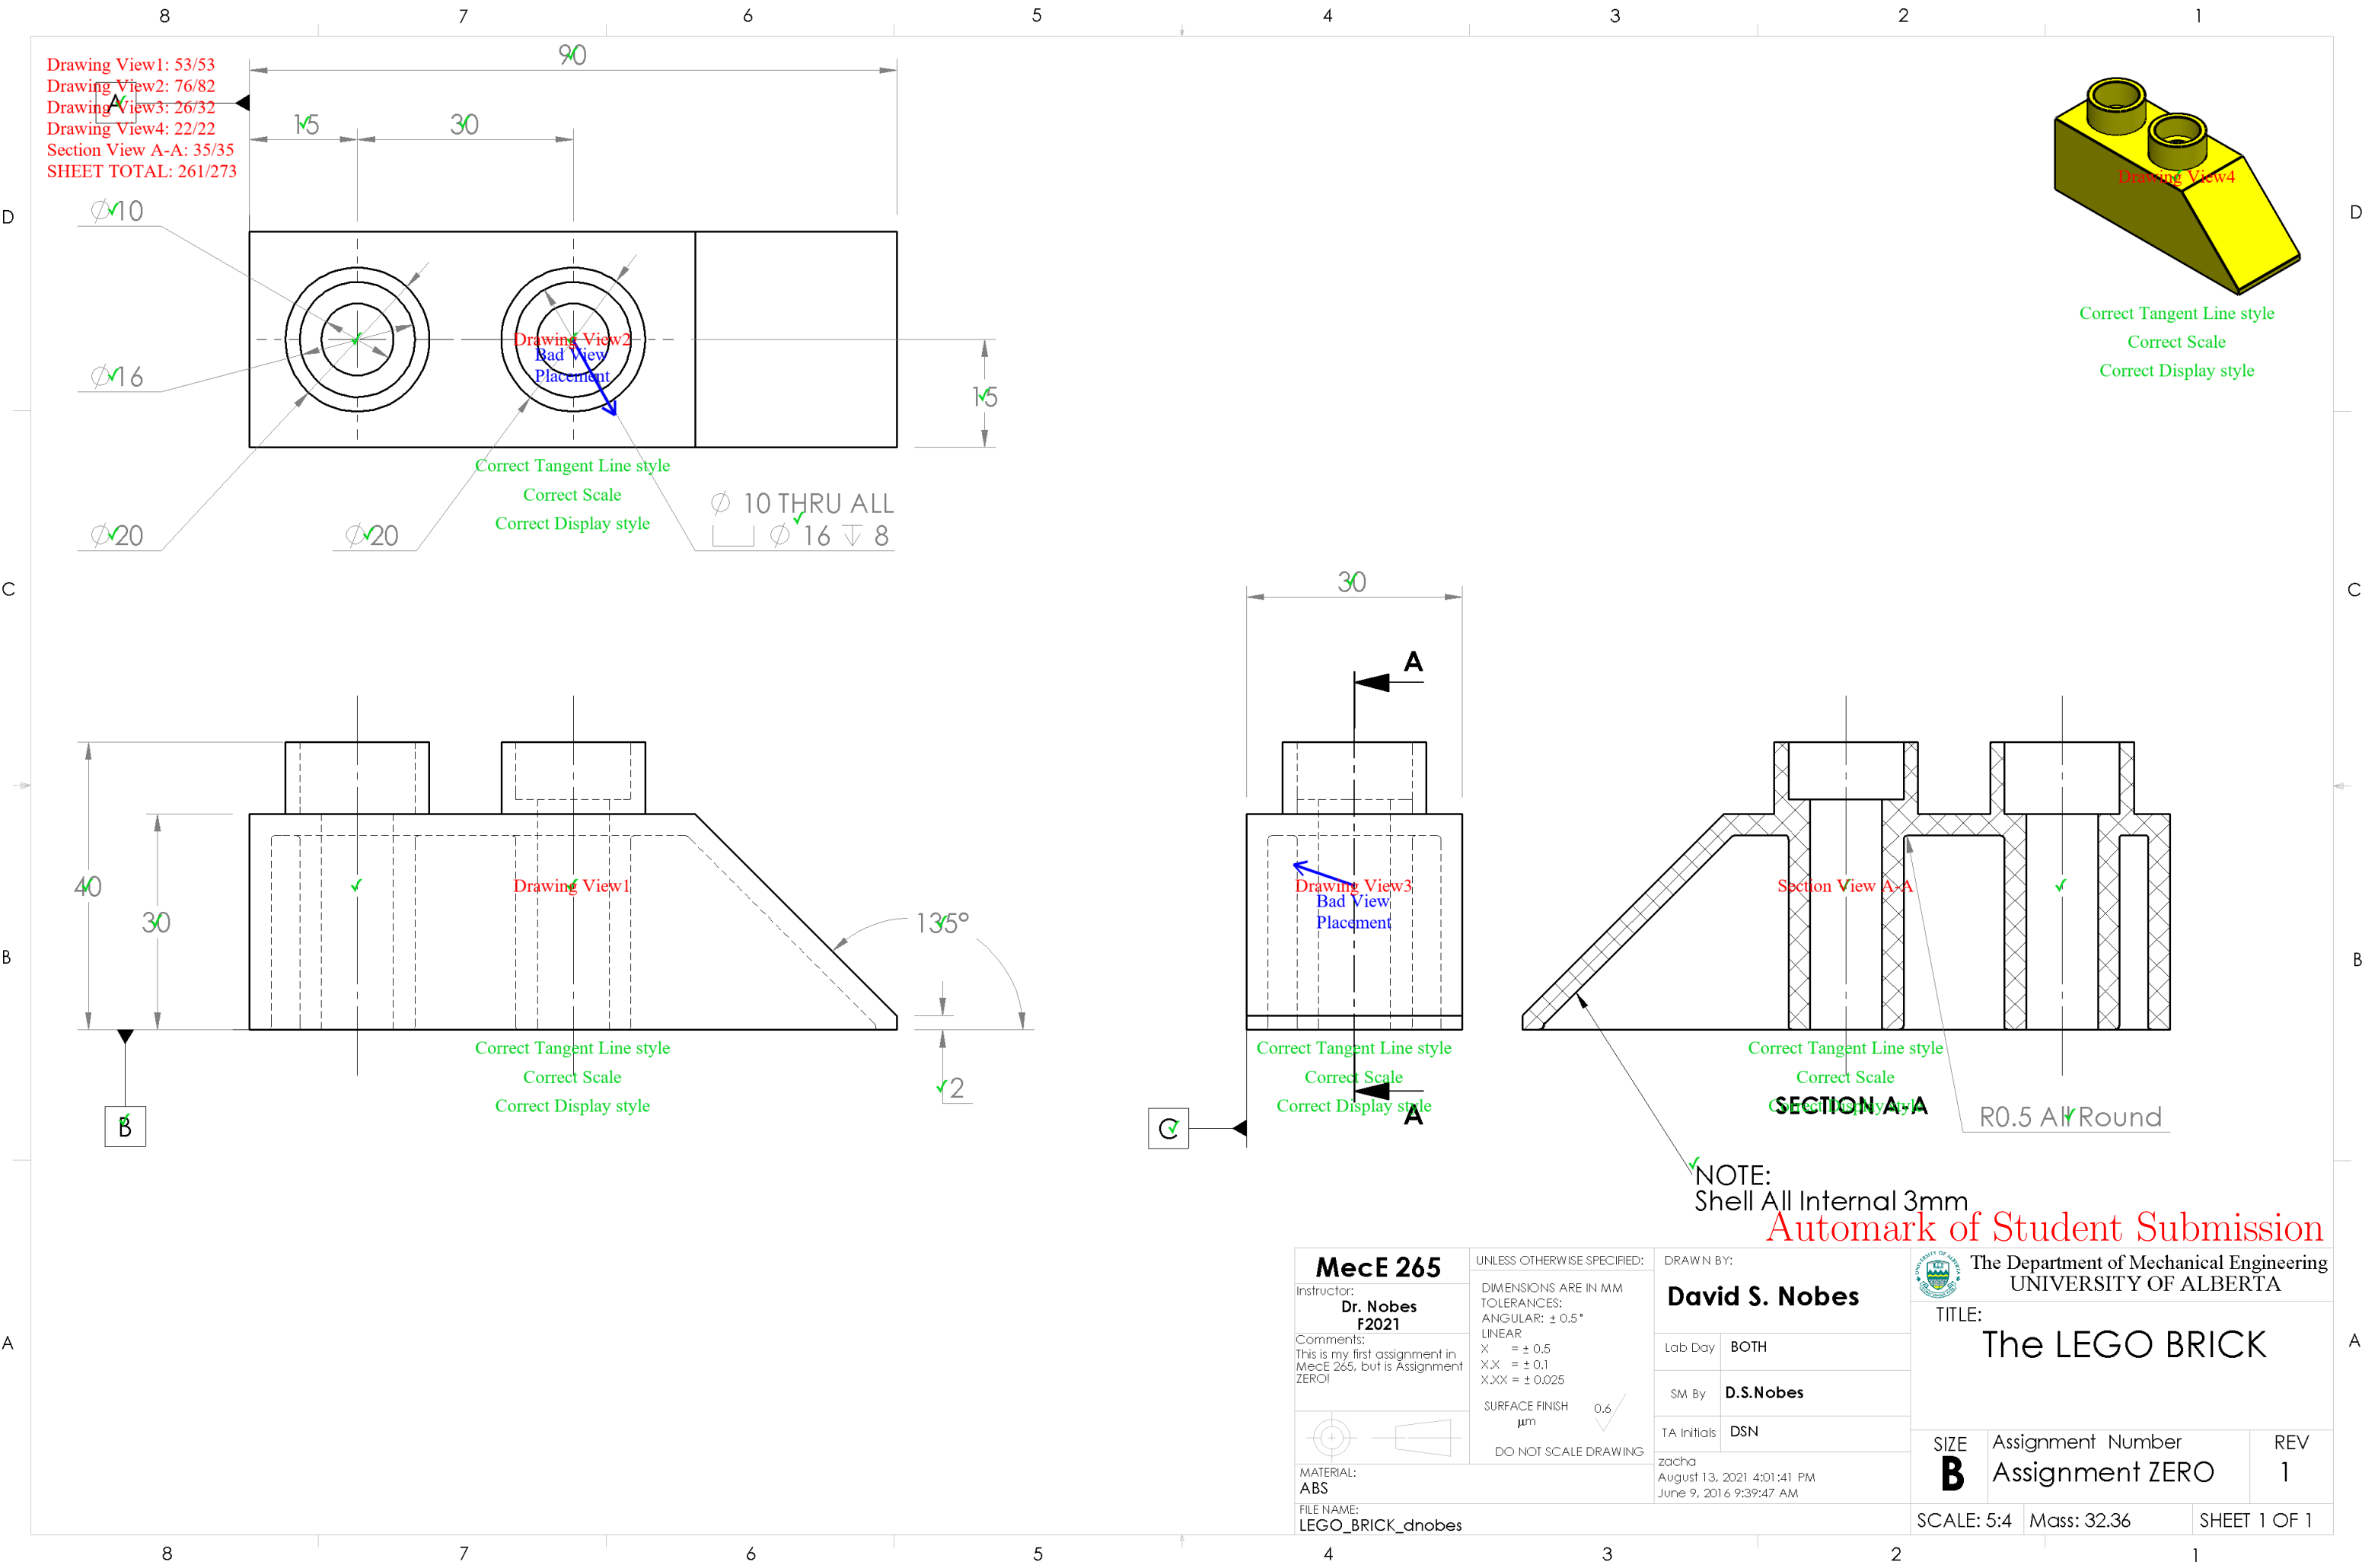

MecE 265

Instructor:
Dr. Nobes
F2021

Comments:
This is my first assignment in
MecE 265, but is Assignment
ZERO!



MATERIAL:
ABS

FILE NAME:
LEGO_BRICK_dnobes

UNLESS OTHERWISE SPECIFIED:

DIMENSIONS ARE IN MM
TOLERANCES:
ANGULAR: $\pm 0.5^\circ$
LINEAR
X = ± 0.5
X.X = ± 0.1
X.XX = ± 0.025

SURFACE FINISH
 μm 0.6

DO NOT SCALE DRAWING

DRAWN BY:

David S. Nobes

Lab Day

BOTH

SM By

D.S.Nobes

TA Initials

DSN

zacha
August 13, 2021 4:01:41 PM
June 9, 2016 9:39:47 AM



The Department of Mechanical Engineering
UNIVERSITY OF ALBERTA

TITLE:

The LEGO BRICK

SIZE

B

Assignment Number

Assignment ZERO


REV

1

SCALE: 5:4

Mass: 32.36

SHEET 1 OF 1

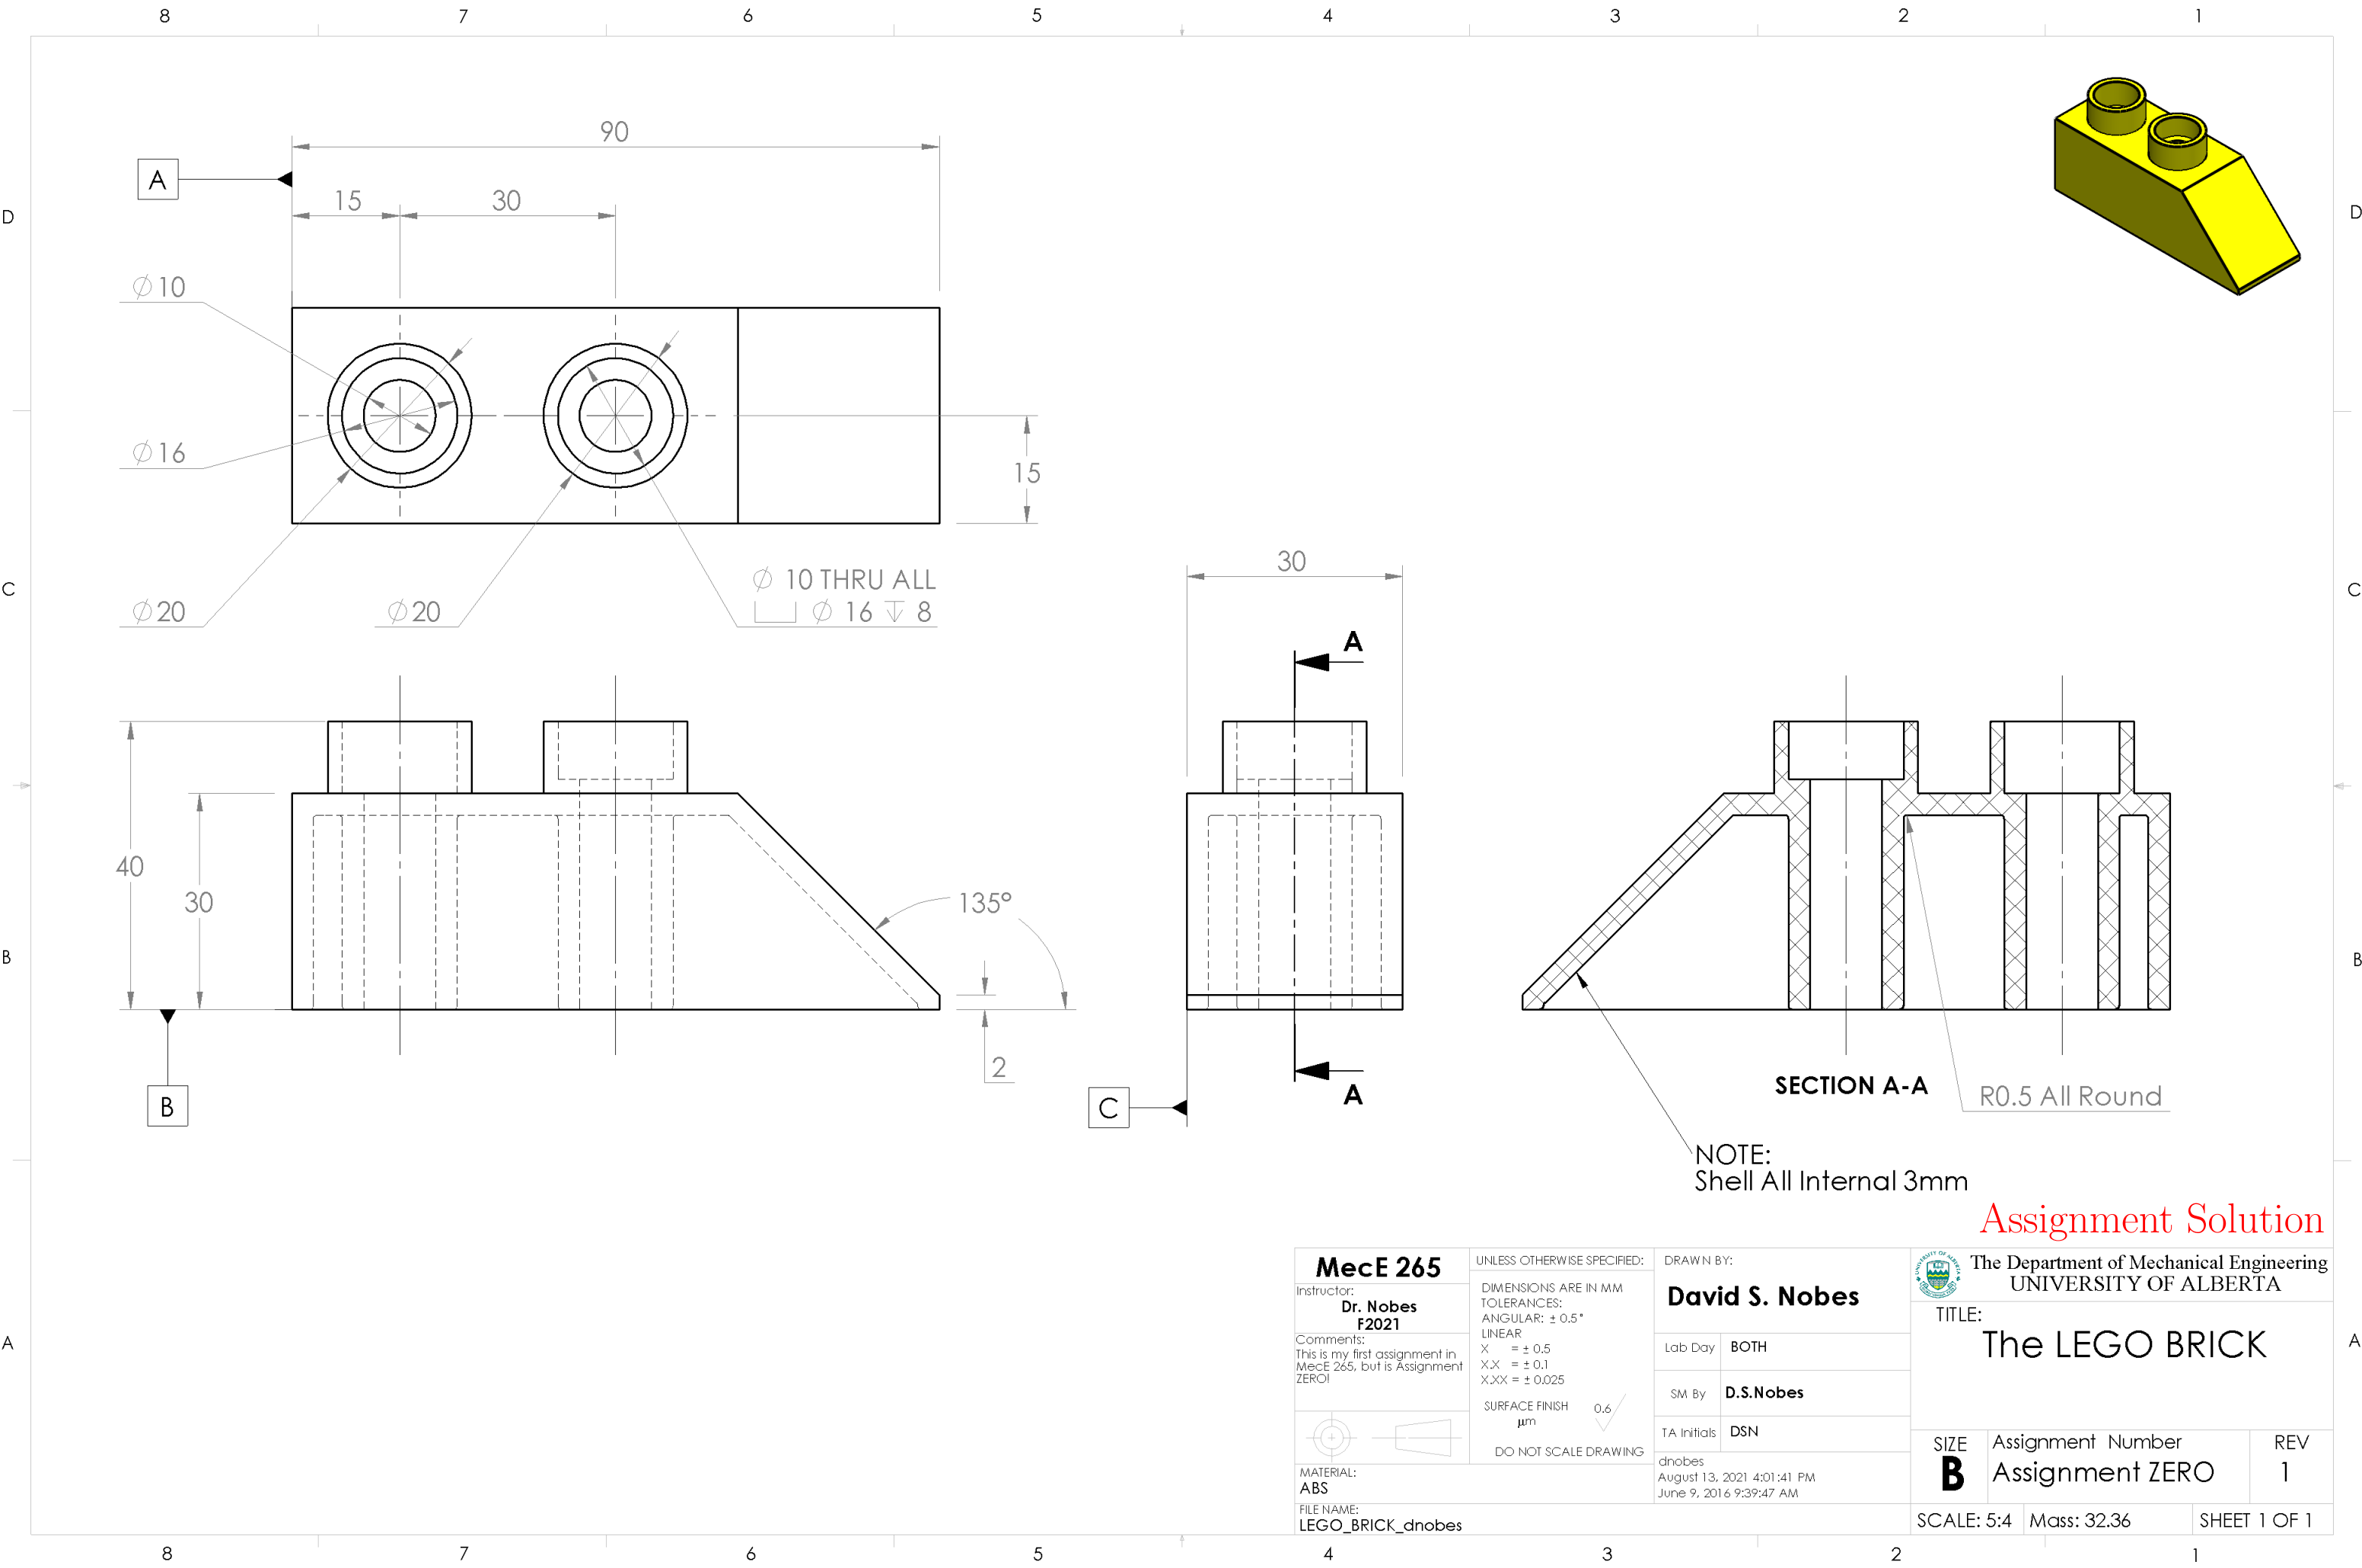

Assignment Solution