



Mec E 468 Numerical Simulation in Mechanical Engineering Design

AUTOMARK REPORT

Semester: Win 2022

Instructor: Prof. David S. Nobes

Student Name:

Assignment: Assignment No 1

PROCESSING DATE: June 30, 2022

AUTOMark Assessment Grade: 290 out of 290

AUTOMark Recommended Grade: 100 out of 100

NOTE: This grade is preliminary only and needs to be confirmed.

The following pages include each of the drawings in the following order:

- Your submission
- Your submission marked by AutoMARK
- The solution

Other important points:

- Examples are given on eClass of how to interpret the mark-up symbols used by AUTOMark.
- If you have any questions, discuss with you TA in the next lab time.

DRAWING CREATION DATE: 23-Dec-2020 16:08:23

DRAWING LAST SAVE DATE: 29-Jun-2022 11:45:18

MODEL CREATION DATE: 09-Jun-2016 09:39:47

MODEL LAST SAVE DATE: 13-Aug-2021 16:01:41



AutoMARK details:

- Sheetnames should contain only alphabetical characters
- Weights of feature properties are set by the marker
- AutoMARK v 4.0 software written and designed by Owen Stadlwieser

AutoMARK Criterion (The weights of these criterion are decided by the marker):

- DRAWING: SheetOrder, ExtraSheets
- SHEET: SheetPaperSize, SheetScale, SheetTemplate, SheetExtraBOMS, SheetExtraViews, SheetViewTypes, SheetIntersectingBallons
- BILLOFMATERIALS: BOMTableType, BOMNumberColumns, BOMNumberRows, BOM-Position, BOMTableHeight, BOMTableWidth, BOMFontType, BOMFontSize
- VIEW: ViewScale, ViewDisplayStyle, ViewExtraDimension, ViewPosition, ViewExtra-CenterMarks, ViewMass, ViewMaterial, ViewExtraDatums, ViewWrongProjection, ViewEx-traCenterlines
- DIMENSION: DimensionDangling, DimensionWrongView, DimensionPosition, Dimen-sionArrowSide, DimensionValue, DimensionBadText
- CENTERLINE: CenterlineDangling, CenterlinePosition
- CENTERMARK: CentermarkDangling, CentermarkPosition, CentermarkShowlines, Cen-termarkAngle, CentermarkConnectionLines, CentermarkExtensions, CentermarkGap, CentermarkSize, CentermarkGroupedCorrectly
- DATUM: DatumDangling, DatumWrongView, DatumPosition, DatumLabel, DatumDis-playStyle, DatumFilledTriangle
- Ballon: BallonDangling, BallonPosition

Symbol/Colour	Meaning
✓	No deductions on feature
Colour	Incorrect value
Colour	Miscellaneous error
Colour	Incorrect Position
Colour	Unrecognized feature
Colour	Missing feature
?	Feature not found on key

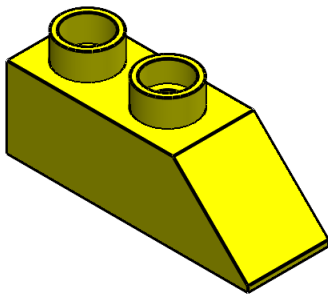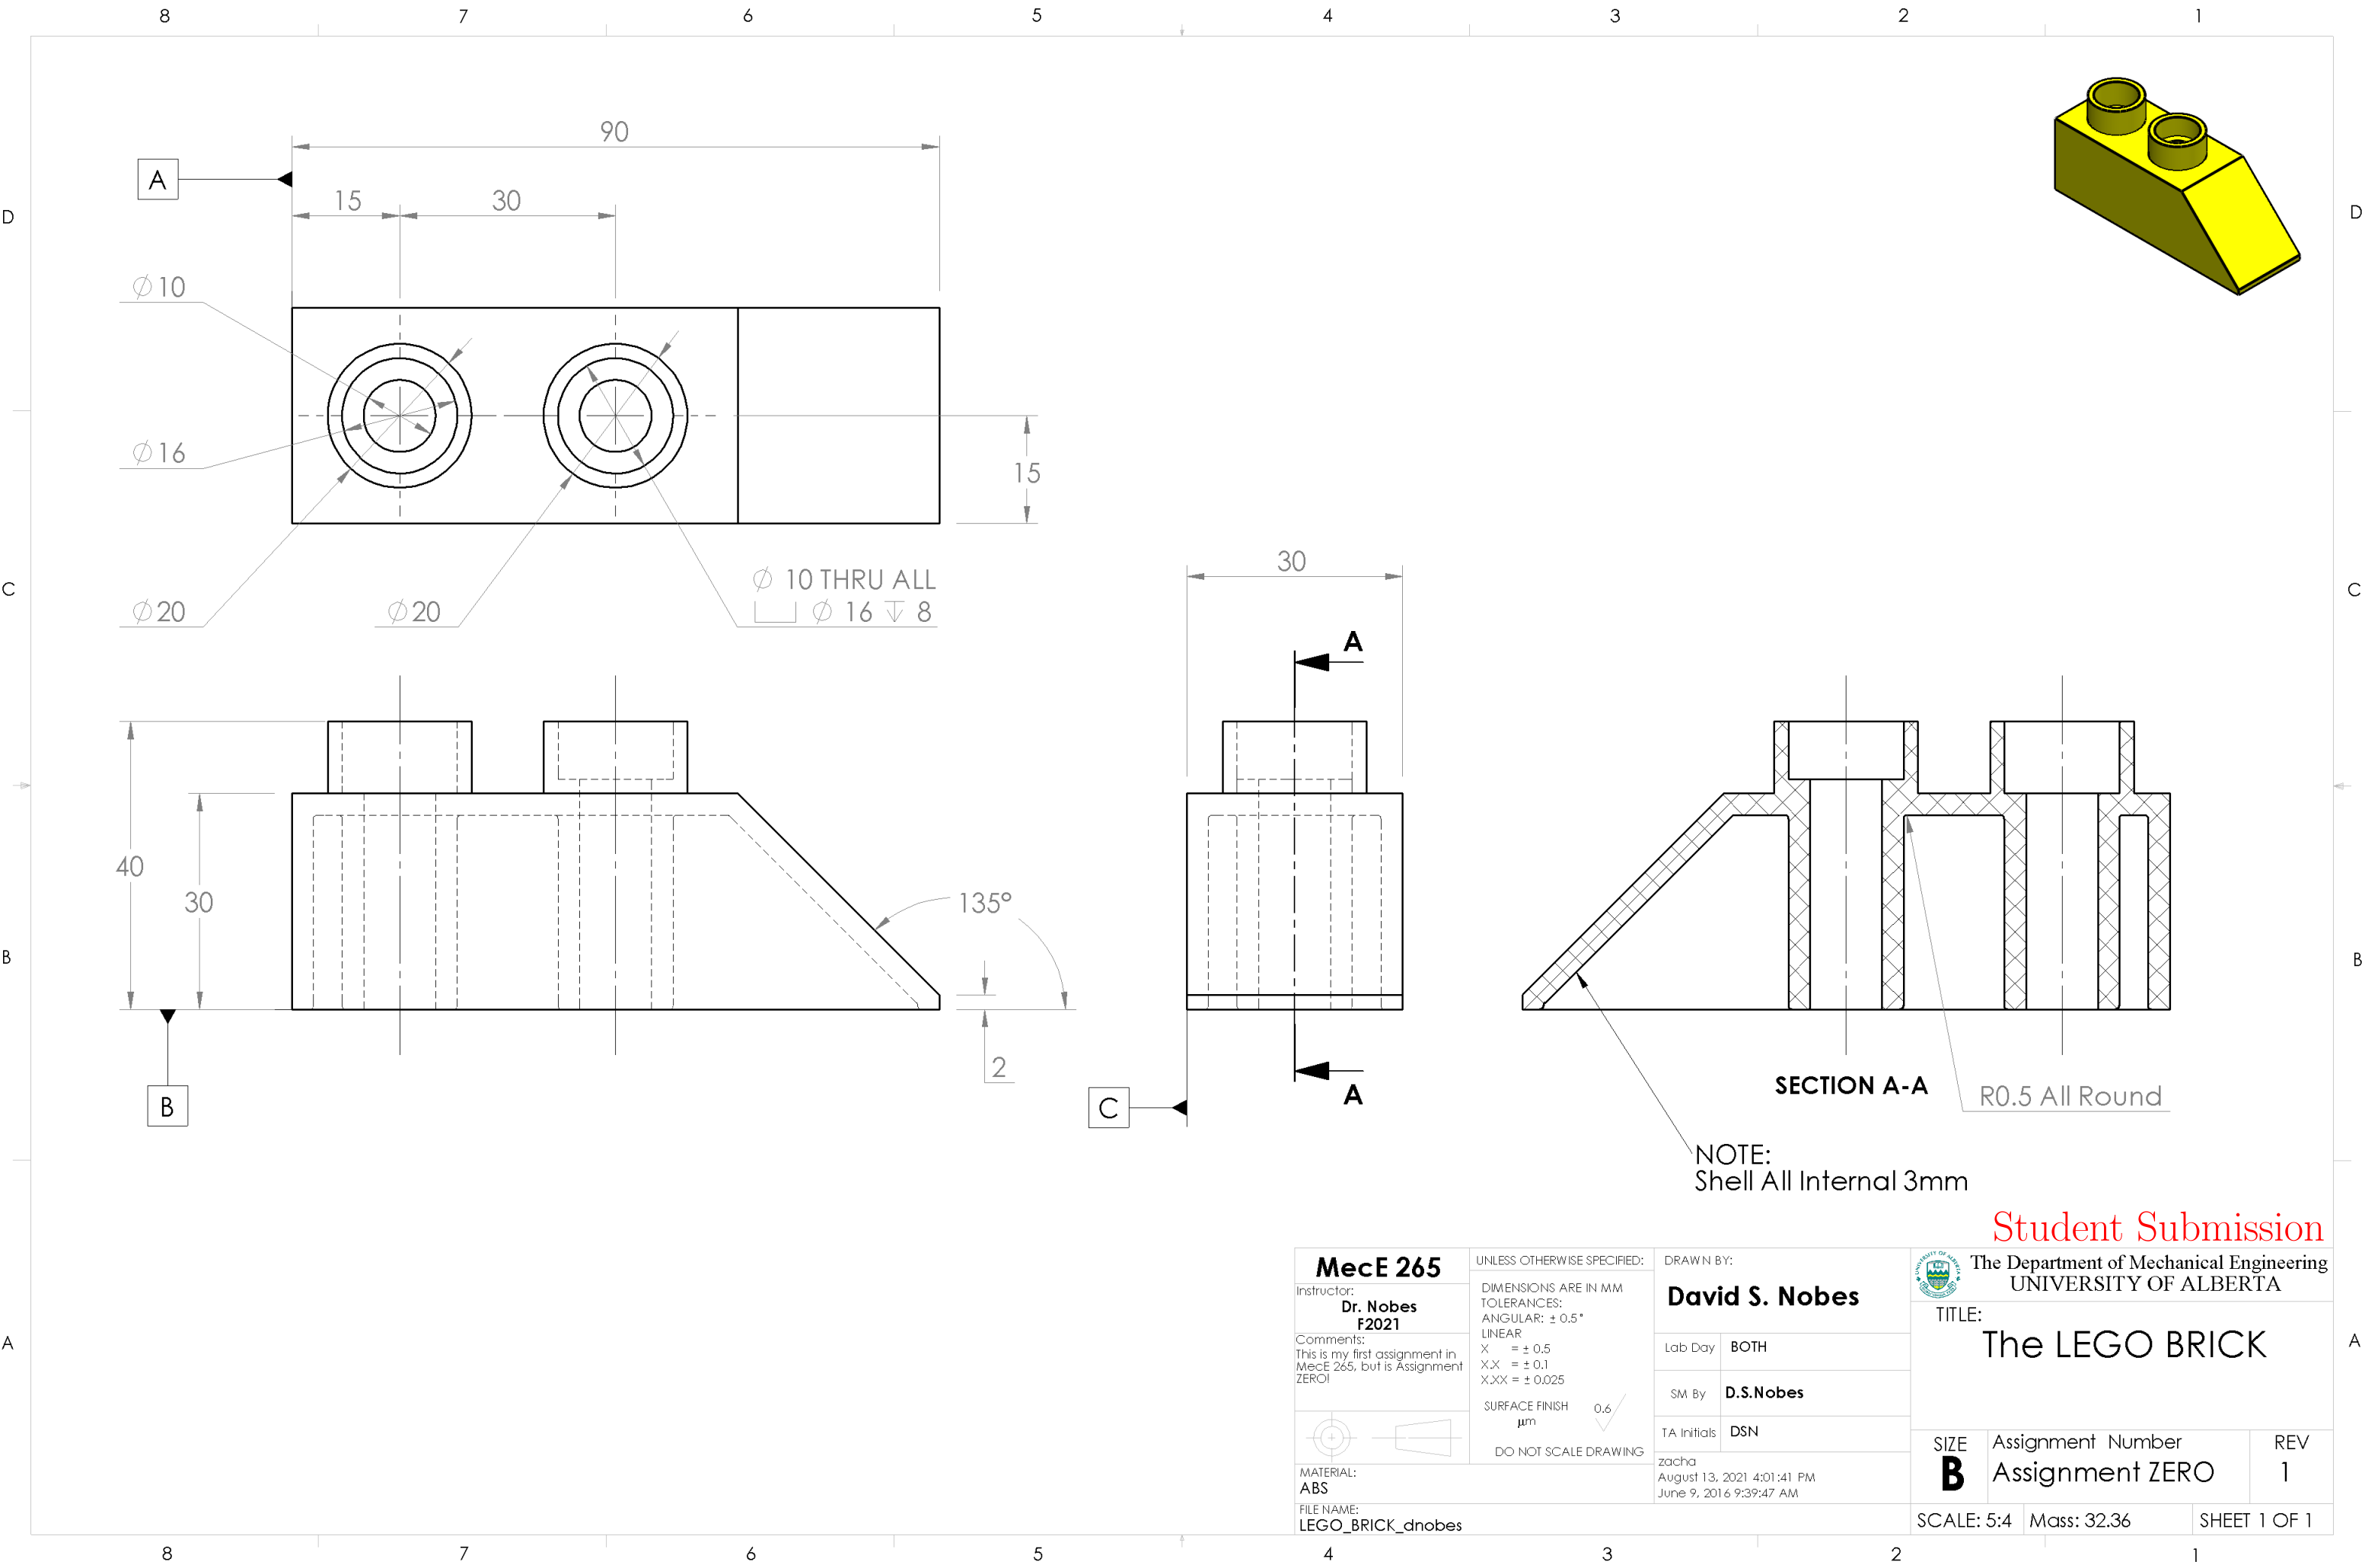



SECTION A-A

R0.5 All Round

NOTE:
Shell All Internal 3mm

Student Submission

<div>MecE 265</div> <div>Instructor: Dr. Nobes F2021</div> <div>Comments: This is my first assignment in MecE 265, but is Assignment ZERO!</div> <div></div> <div>MATERIAL: ABS</div> <div>FILE NAME: LEGO_BRICK_dnobes</div>		<div>UNLESS OTHERWISE SPECIFIED:</div> <div>DIMENSIONS ARE IN MM TOLERANCES: ANGULAR: ± 0.5° LINEAR X = ± 0.5 X.X = ± 0.1 X.XX = ± 0.025</div> <div>SURFACE FINISH μm 0.6</div> <div>DO NOT SCALE DRAWING</div>		<div>DRAWN BY:</div> <div>David S. Nobes</div> <div>Lab Day BOTH</div> <div>SM By D.S.Nobes</div> <div>TA Initials DSN</div> <div>zacha August 13, 2021 4:01:41 PM June 9, 2016 9:39:47 AM</div>		<div>The Department of Mechanical Engineering UNIVERSITY OF ALBERTA</div> <div>TITLE: The LEGO BRICK</div> <div>SIZE B</div> <div>Assignment Number Assignment ZERO</div> <div>REV 1</div> <div>SCALE: 5:4</div> <div>Mass: 32.36</div> <div>SHEET 1 OF 1</div>	
--	--	---	--	--	--	--	--

A

A




A





A

A

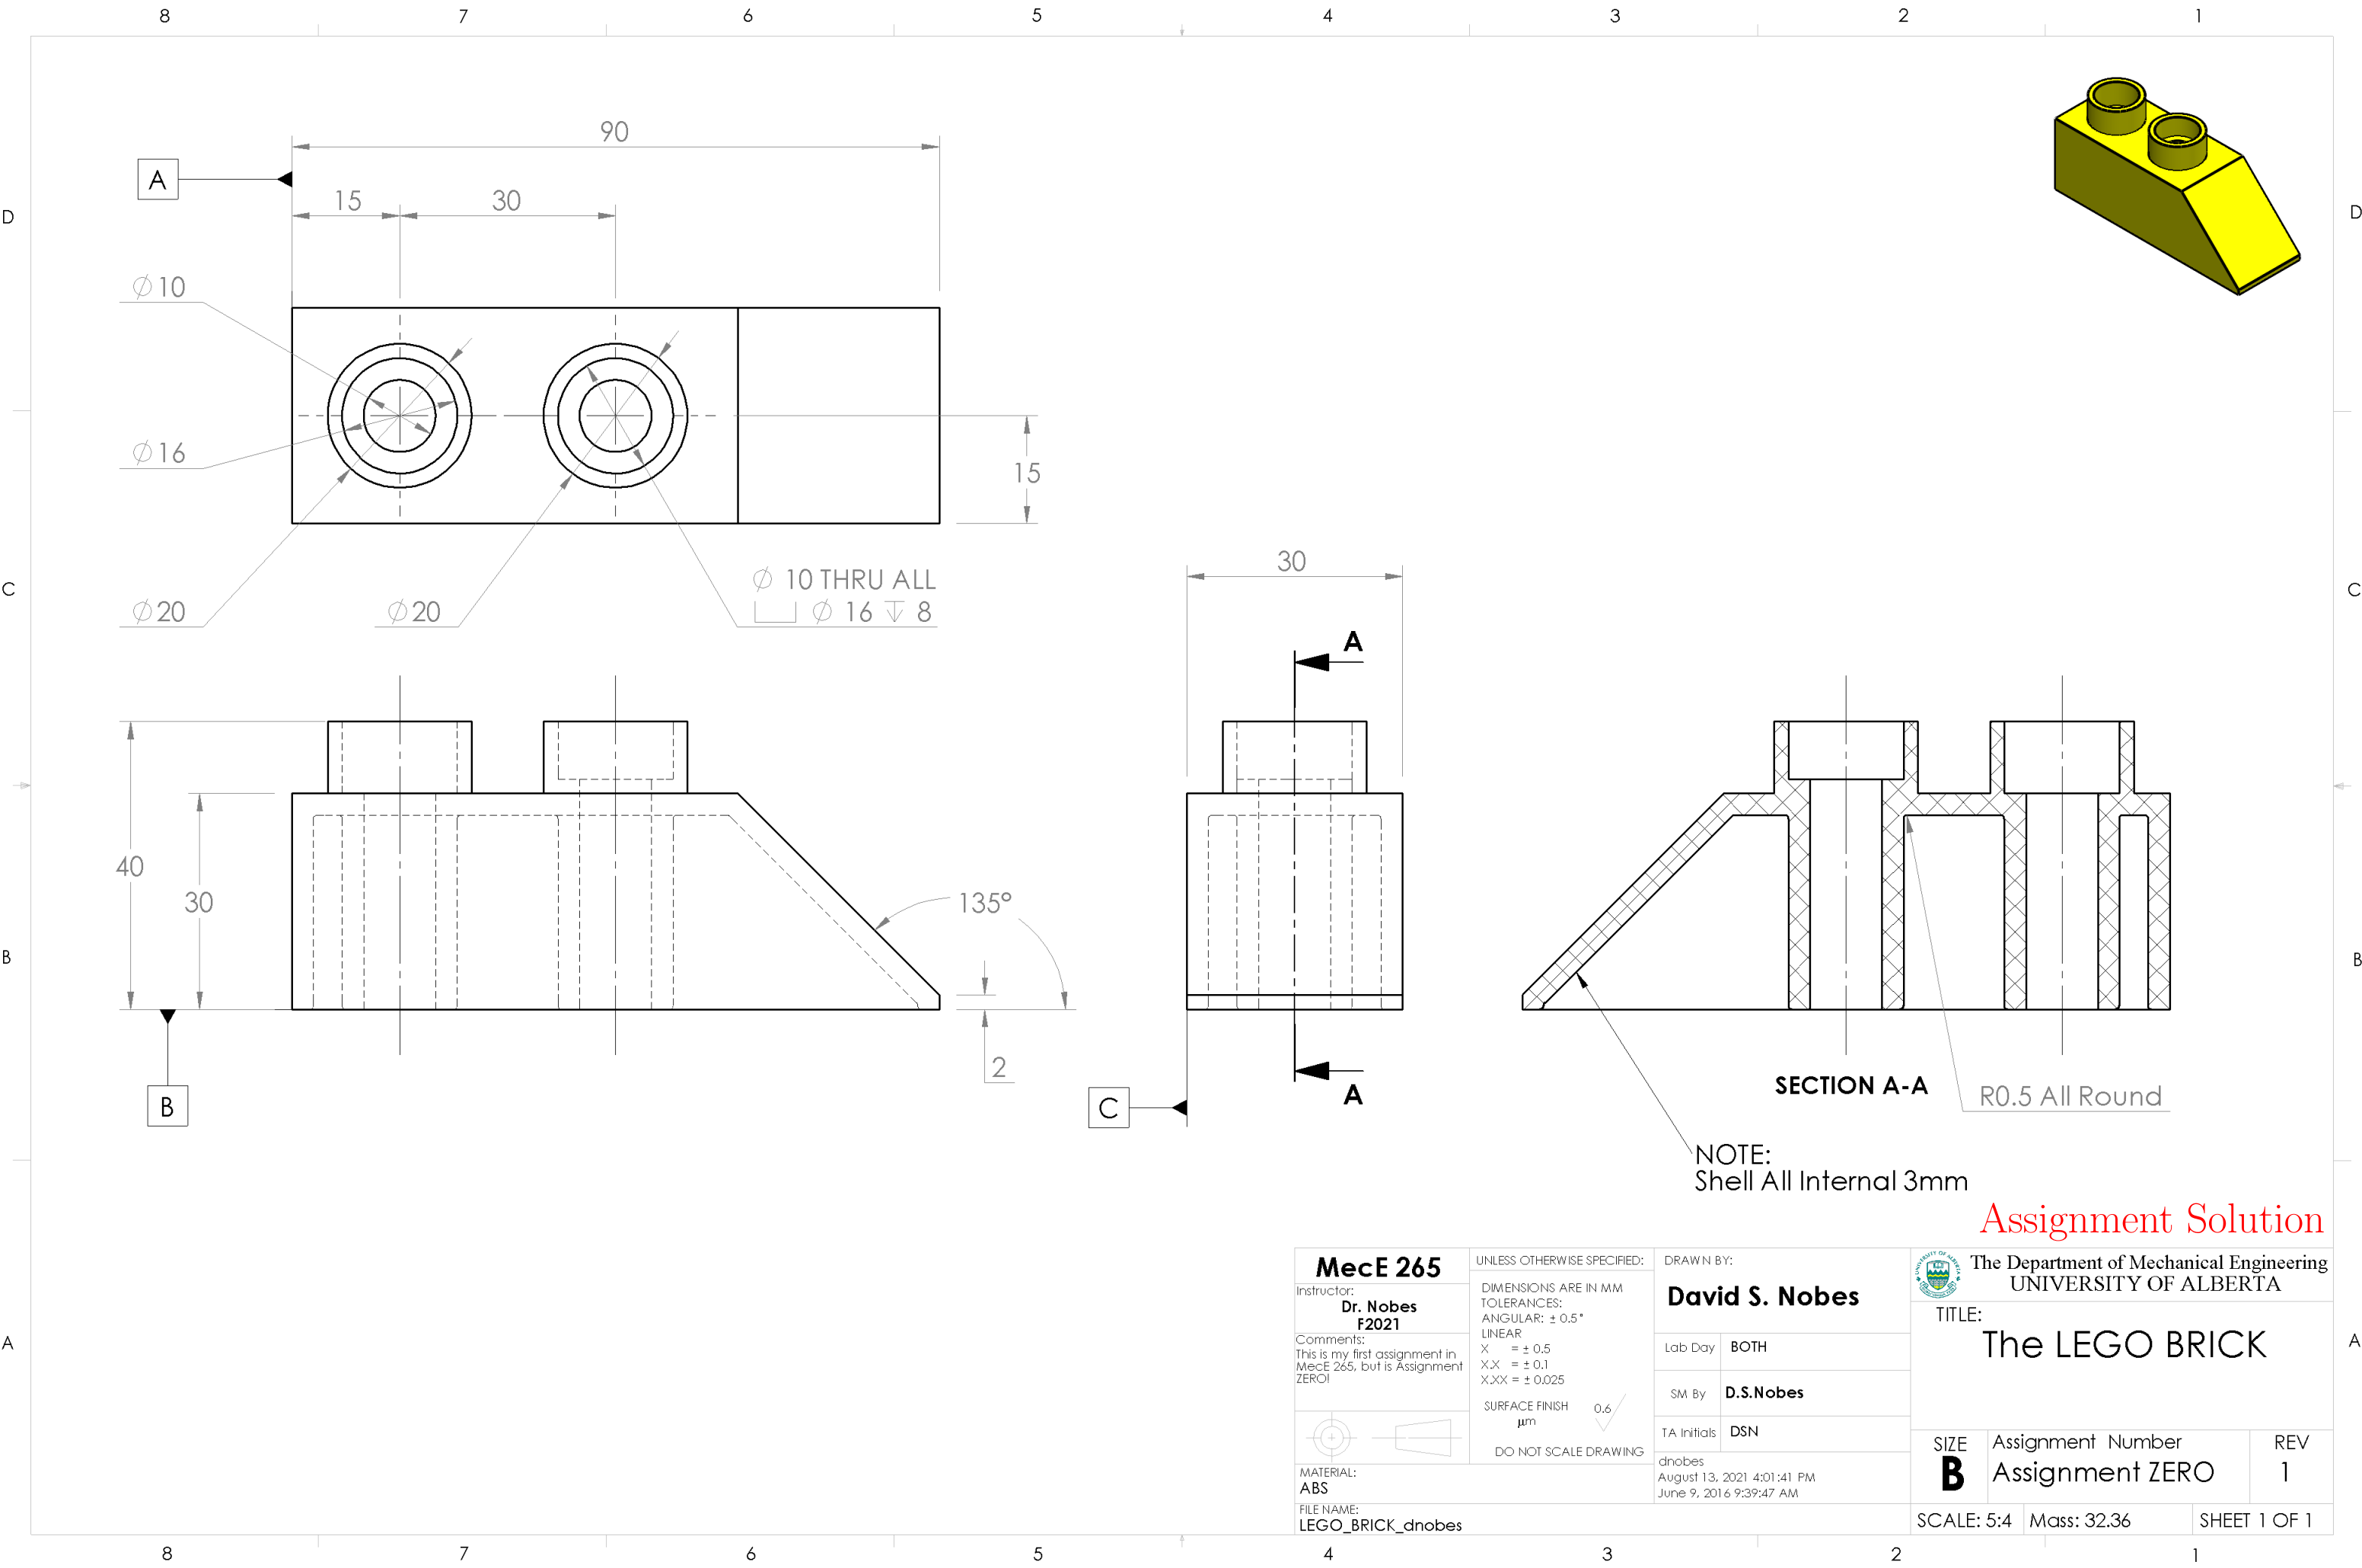A



Assignment Solution

MecE 265		UNLESS OTHERWISE SPECIFIED:		DRAWN BY:		 The Department of Mechanical Engineering UNIVERSITY OF ALBERTA		
Instructor: Dr. Nobes F2021		DIMENSIONS ARE IN MM TOLERANCES: ANGULAR: $\pm 0.5^\circ$ LINEAR X = ± 0.5 X.X = ± 0.1 X.XX = ± 0.025		David S. Nobes		TITLE:		
Comments: This is my first assignment in MecE 265, but is Assignment ZERO!		SURFACE FINISH μm 0.6 ✓		Lab Day	BOTH	The LEGO BRICK		
		DO NOT SCALE DRAWING		SM By	D.S.Nobes			
MATERIAL: ABS				TA Initials	DSN	SIZE B	Assignment Number Assignment ZERO	REV 1
FILE NAME: LEGO_BRICK_dnobes				dnobes August 13, 2021 4:01:41 PM June 9, 2016 9:39:47 AM		SCALE: 5:4	Mass: 32.36	SHEET 1 OF 1