



Mec E 468 Numerical Simulation in Mechanical Engineering Design

AUTOMARK REPORT

Semester: Win 2022

Instructor: Prof. David S. Nobes

Student Name:

Assignment: Assignment No 1

PROCESSING DATE: August 10, 2022

AUTOMark Assessment Grade: 290 out of 291

AUTOMark Recommended Grade: 100 out of 100

NOTE: This grade is preliminary only and needs to be confirmed.

The following pages include each of the drawings in the following order:

- Your submission
- Your submission marked by AutoMARK
- The solution

Other important points:

- Examples are given on eClass of how to interpret the mark-up symbols used by AUTOMark.
- If you have any questions, discuss with you TA in the next lab time.

DRAWING CREATION DATE: 31-Dec-2019 13:57:09

DRAWING LAST SAVE DATE: 29-Jun-2022 10:15:10

MODEL CREATION DATE: 29-Dec-2019 12:49:16

MODEL LAST SAVE DATE: 07-Sep-2021 10:33:58


AutoMARK details:

- Sheetnames should contain only alphabetical characters
- Weights of feature properties are set by the marker
- AutoMARK v 4.0 software written and designed by Owen Stadlwieser

AutoMARK Criterion (The weights of these criterion are decided by the marker):

- DRAWING: SheetOrder, ExtraSheets
- SHEET: SheetPaperSize, SheetScale, SheetTemplate, SheetExtraBOMS, SheetExtraViews, SheetViewTypes, SheetIntersectingBallons
- BILLOFMATERIALS: BOMTableType, BOMNumberColumns, BOMNumberRows, BOM-Position, BOMTableHeight, BOMTableWidth, BOMFontType, BOMFontSize
- VIEW: ViewScale, ViewDisplayStyle, ViewExtraDimension, ViewPosition, ViewExtra-CenterMarks, ViewMass, ViewMaterial, ViewExtraDatums, ViewWrongProjection, ViewEx-traCenterlines
- DIMENSION: DimensionDangling, DimensionWrongView, DimensionPosition, Dimen-sionArrowSide, DimensionValue, DimensionBadText
- CENTERLINE: CenterlineDangling, CenterlinePosition
- CENTERMARK: CentermarkDangling, CentermarkPosition, CentermarkShowlines, Cen-termarkAngle, CentermarkConnectionLines, CentermarkExtensions, CentermarkGap, CentermarkSize, CentermarkGroupedCorrectly
- DATUM: DatumDangling, DatumWrongView, DatumPosition, DatumLabel, DatumDis-playStyle, DatumFilledTriangle
- Ballon: BallonDangling, BallonPosition

Symbol/Colour	Meaning
✓	No deductions on feature
Colour	Incorrect value
Colour	Miscellaneous error
Colour	Incorrect Position
Colour	Unrecognized feature
Colour	Missing feature
?	Feature not found on key

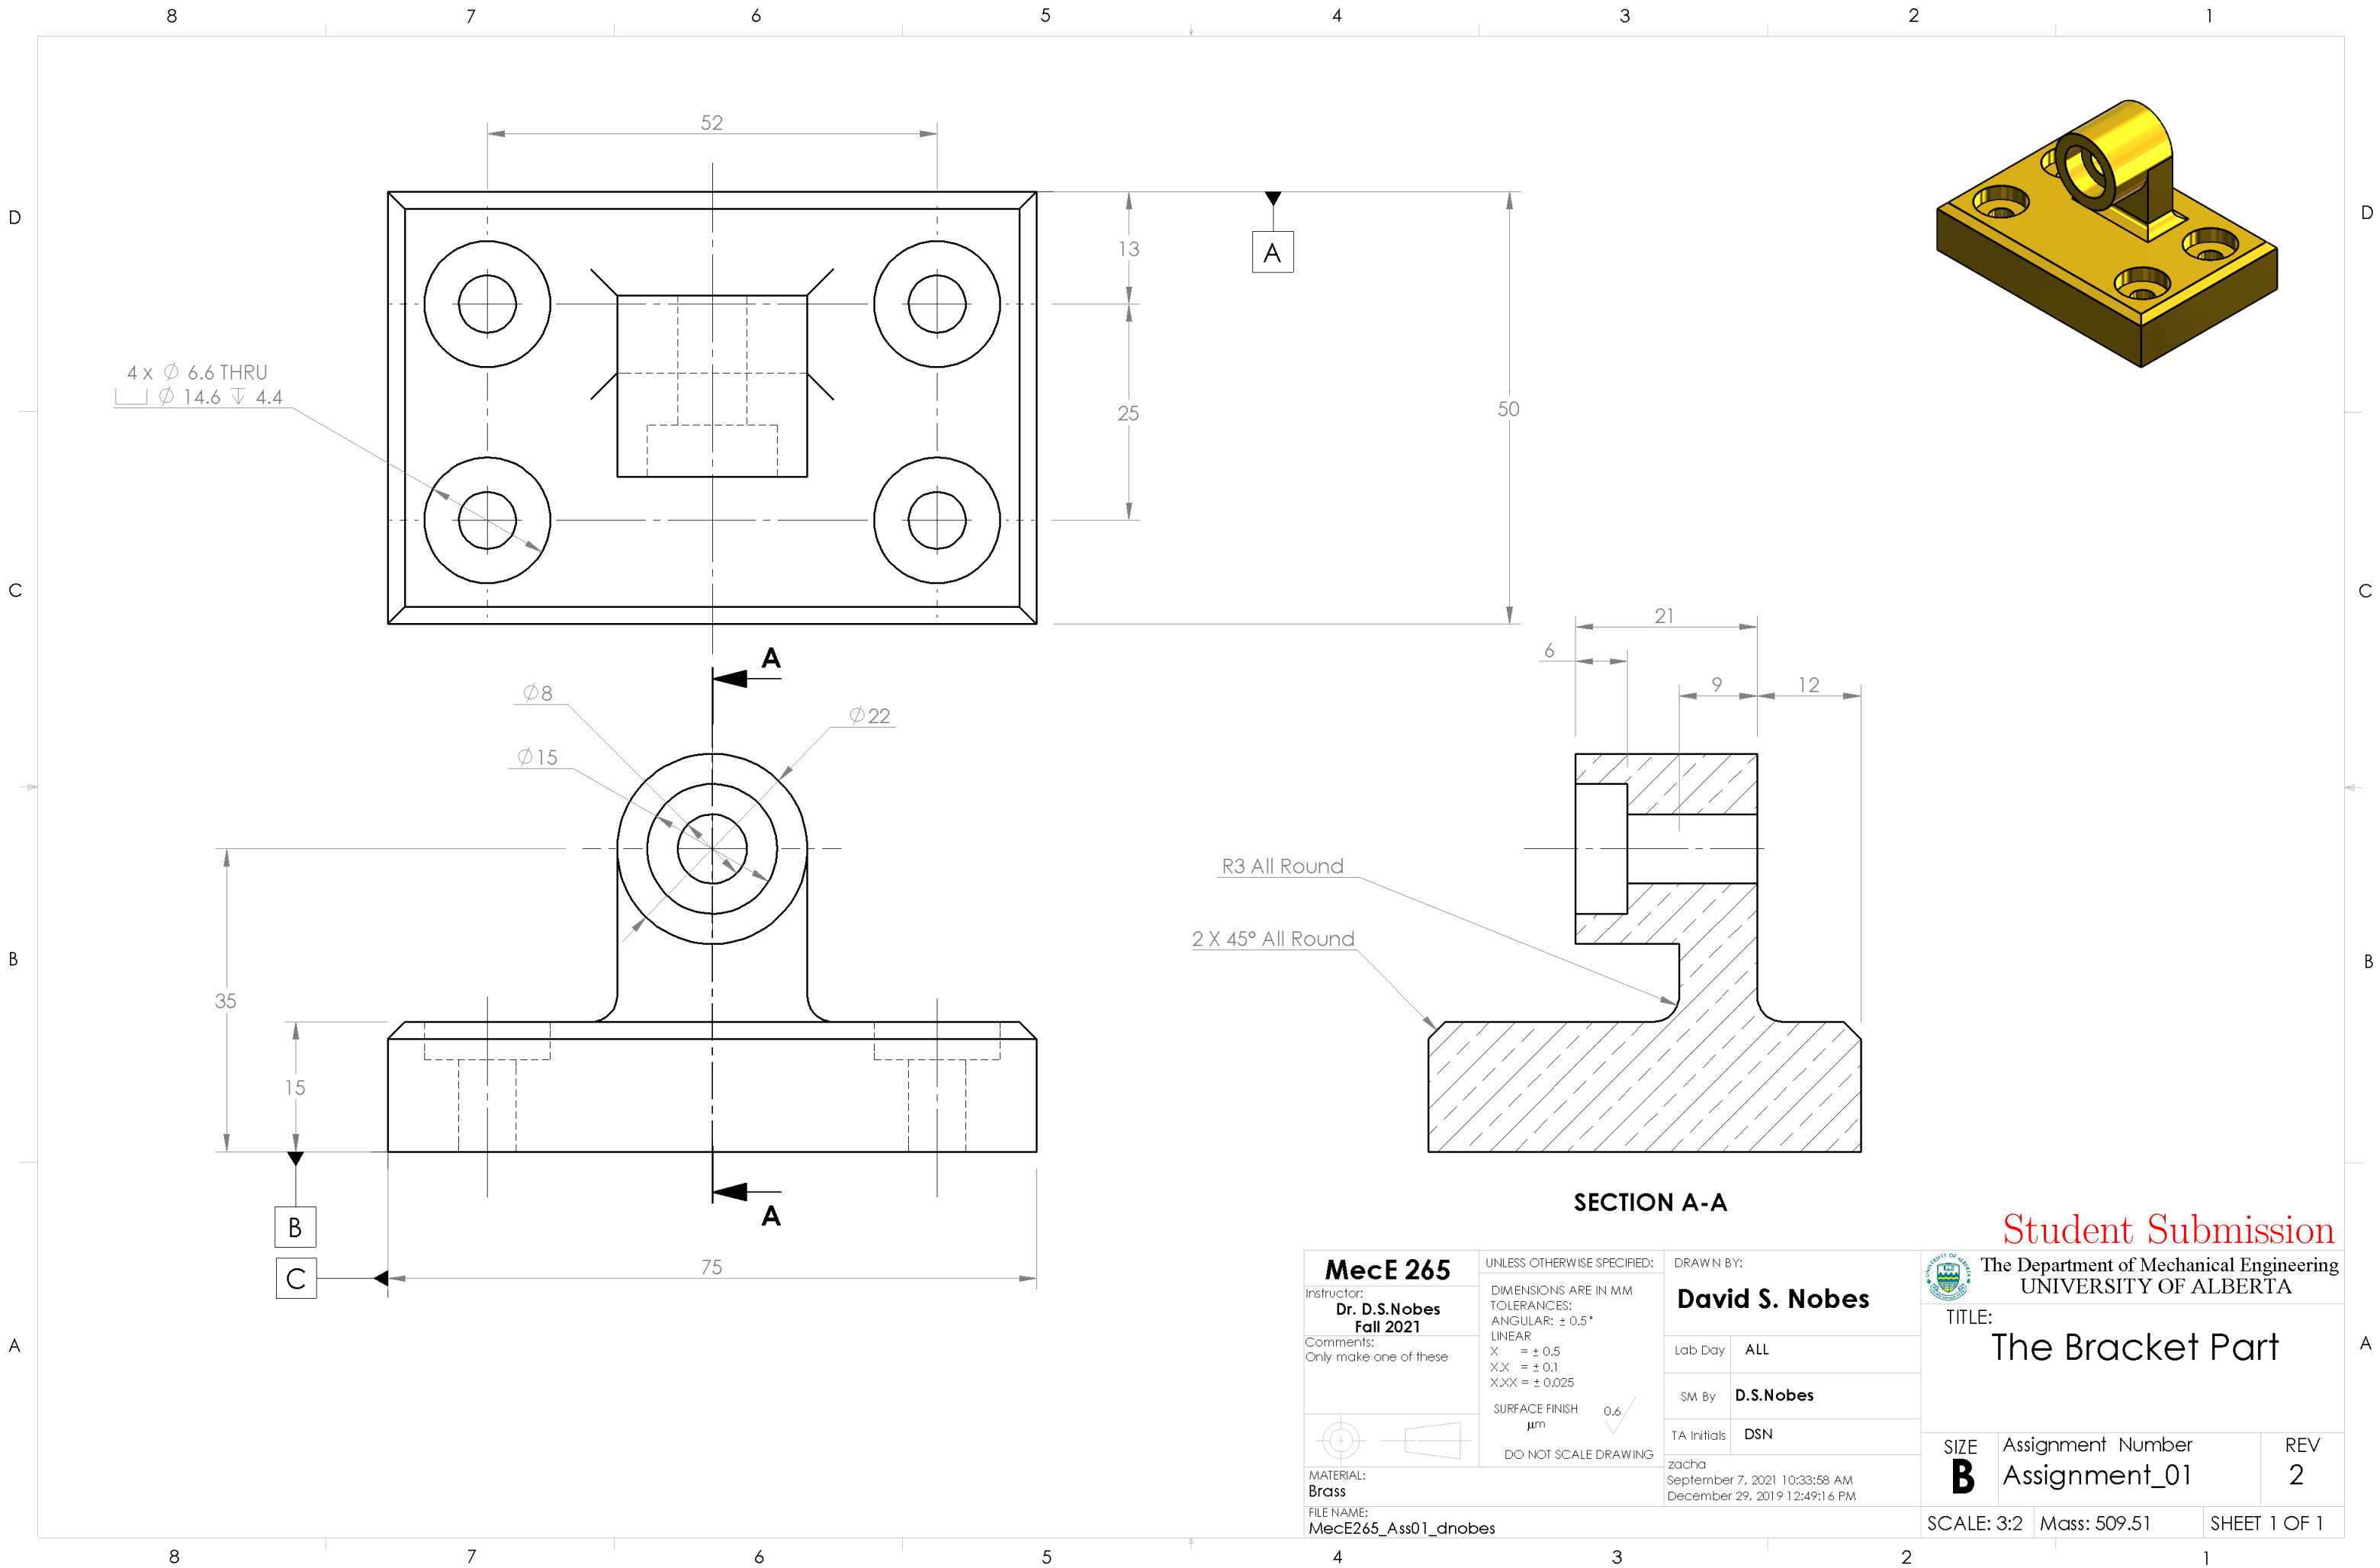

Student Submission



The Department of Mechanical Engineering
UNIVERSITY OF ALBERTA

TITLE:
The Bracket Part

SIZE **B** Assignment Number
Assignment_01 REV
2

SCALE: 3:2 Mass: 509.51 SHEET 1 OF 1

MecE 265

Instructor:
Dr. D.S.Nobes
Fall 2021

Comments:
Only make one of these



MATERIAL:
Brass
FILE NAME:
MecE265_Ass01_dnobes

UNLESS OTHERWISE SPECIFIED:

DIMENSIONS ARE IN MM
TOLERANCES:
ANGULAR: $\pm 0.5^\circ$
LINEAR
X = ± 0.5
X.X = ± 0.1
X.XX = ± 0.025

SURFACE FINISH
 μm 0.6

DO NOT SCALE DRAWING

DRAWN BY:

David S. Nobes

Lab Day

ALL

SM By

D.S.Nobes


TA Initials

DSN

zacha
September 7, 2021 10:33:58 AM
December 29, 2019 12:49:16 PM


Drawing View1: 73/73
Drawing View2: 74/75
Drawing View3: 22/22
Section View A-A: 55/55
SHEET TOTAL: 273/274

4 x \varnothing 6.6 THRU
 \varnothing 14.6 ∇ 4.4

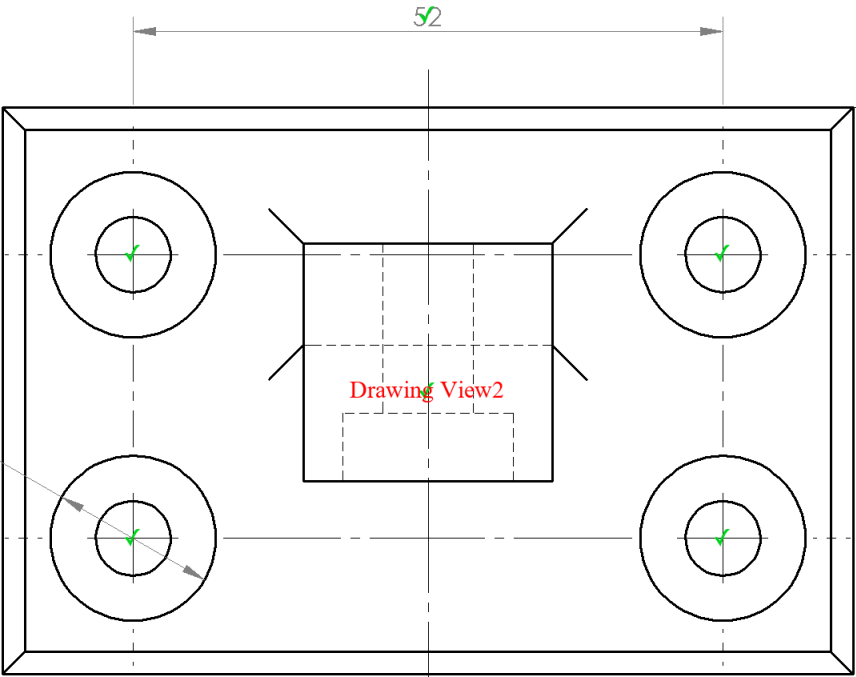

Drawing View2

A

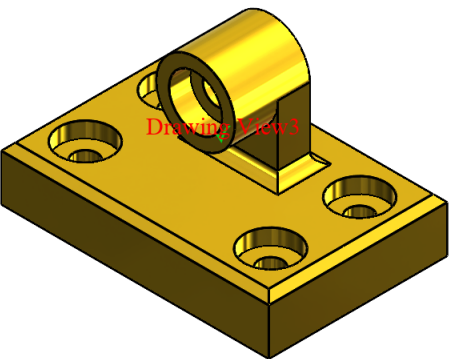

Correct Tangent Line style
Correct Scale
Correct Display style

Correct Tangent Line style
Correct Scale
Correct Display style

\varnothing 8

\varnothing 15

\varnothing 22

Drawing View1

35

∇ 5

B

C

Correct Tangent Line style
Correct Scale
Correct Display style

∇ 5

R3 All Round

2 X 45° All Round

Section View A-A

Correct Tangent Line style
Correct Scale
Correct Display style

SECTION A-A

Automark of Student Submission

MecE 265		UNLESS OTHERWISE SPECIFIED:		DRAWN BY:		The Department of Mechanical Engineering UNIVERSITY OF ALBERTA		
Instructor: Dr. D.S.Nobes Fall 2021		DIMENSIONS ARE IN MM TOLERANCES: ANGULAR: $\pm 0.5^\circ$ LINEAR X = ± 0.5 X.X = ± 0.1 X.XX = ± 0.025		David S. Nobes		TITLE: The Bracket Part		
Comments: Only make one of these		SURFACE FINISH μm 0.6		Lab Day	ALL	SIZE	Assignment Number	REV
		DO NOT SCALE DRAWING		SM By	D.S.Nobes	B	Assignment_01	2
MATERIAL: Brass		zacha September 7, 2021 10:33:58 AM December 29, 2019 12:49:16 PM		TA Initials	DSN	SCALE: 3:2 Mass: 509.51 SHEET 1 OF 1		
FILE NAME: MecE265_Ass01_dnobes								

